


INDICATIVE - SUBJECT TO DETAILED DESIGN

Supplementary Report to Landscape and Visual Assessment

Appendix 5

Preliminary Design Plans (Revision J)

+ markups of safety barriers and wheel guards

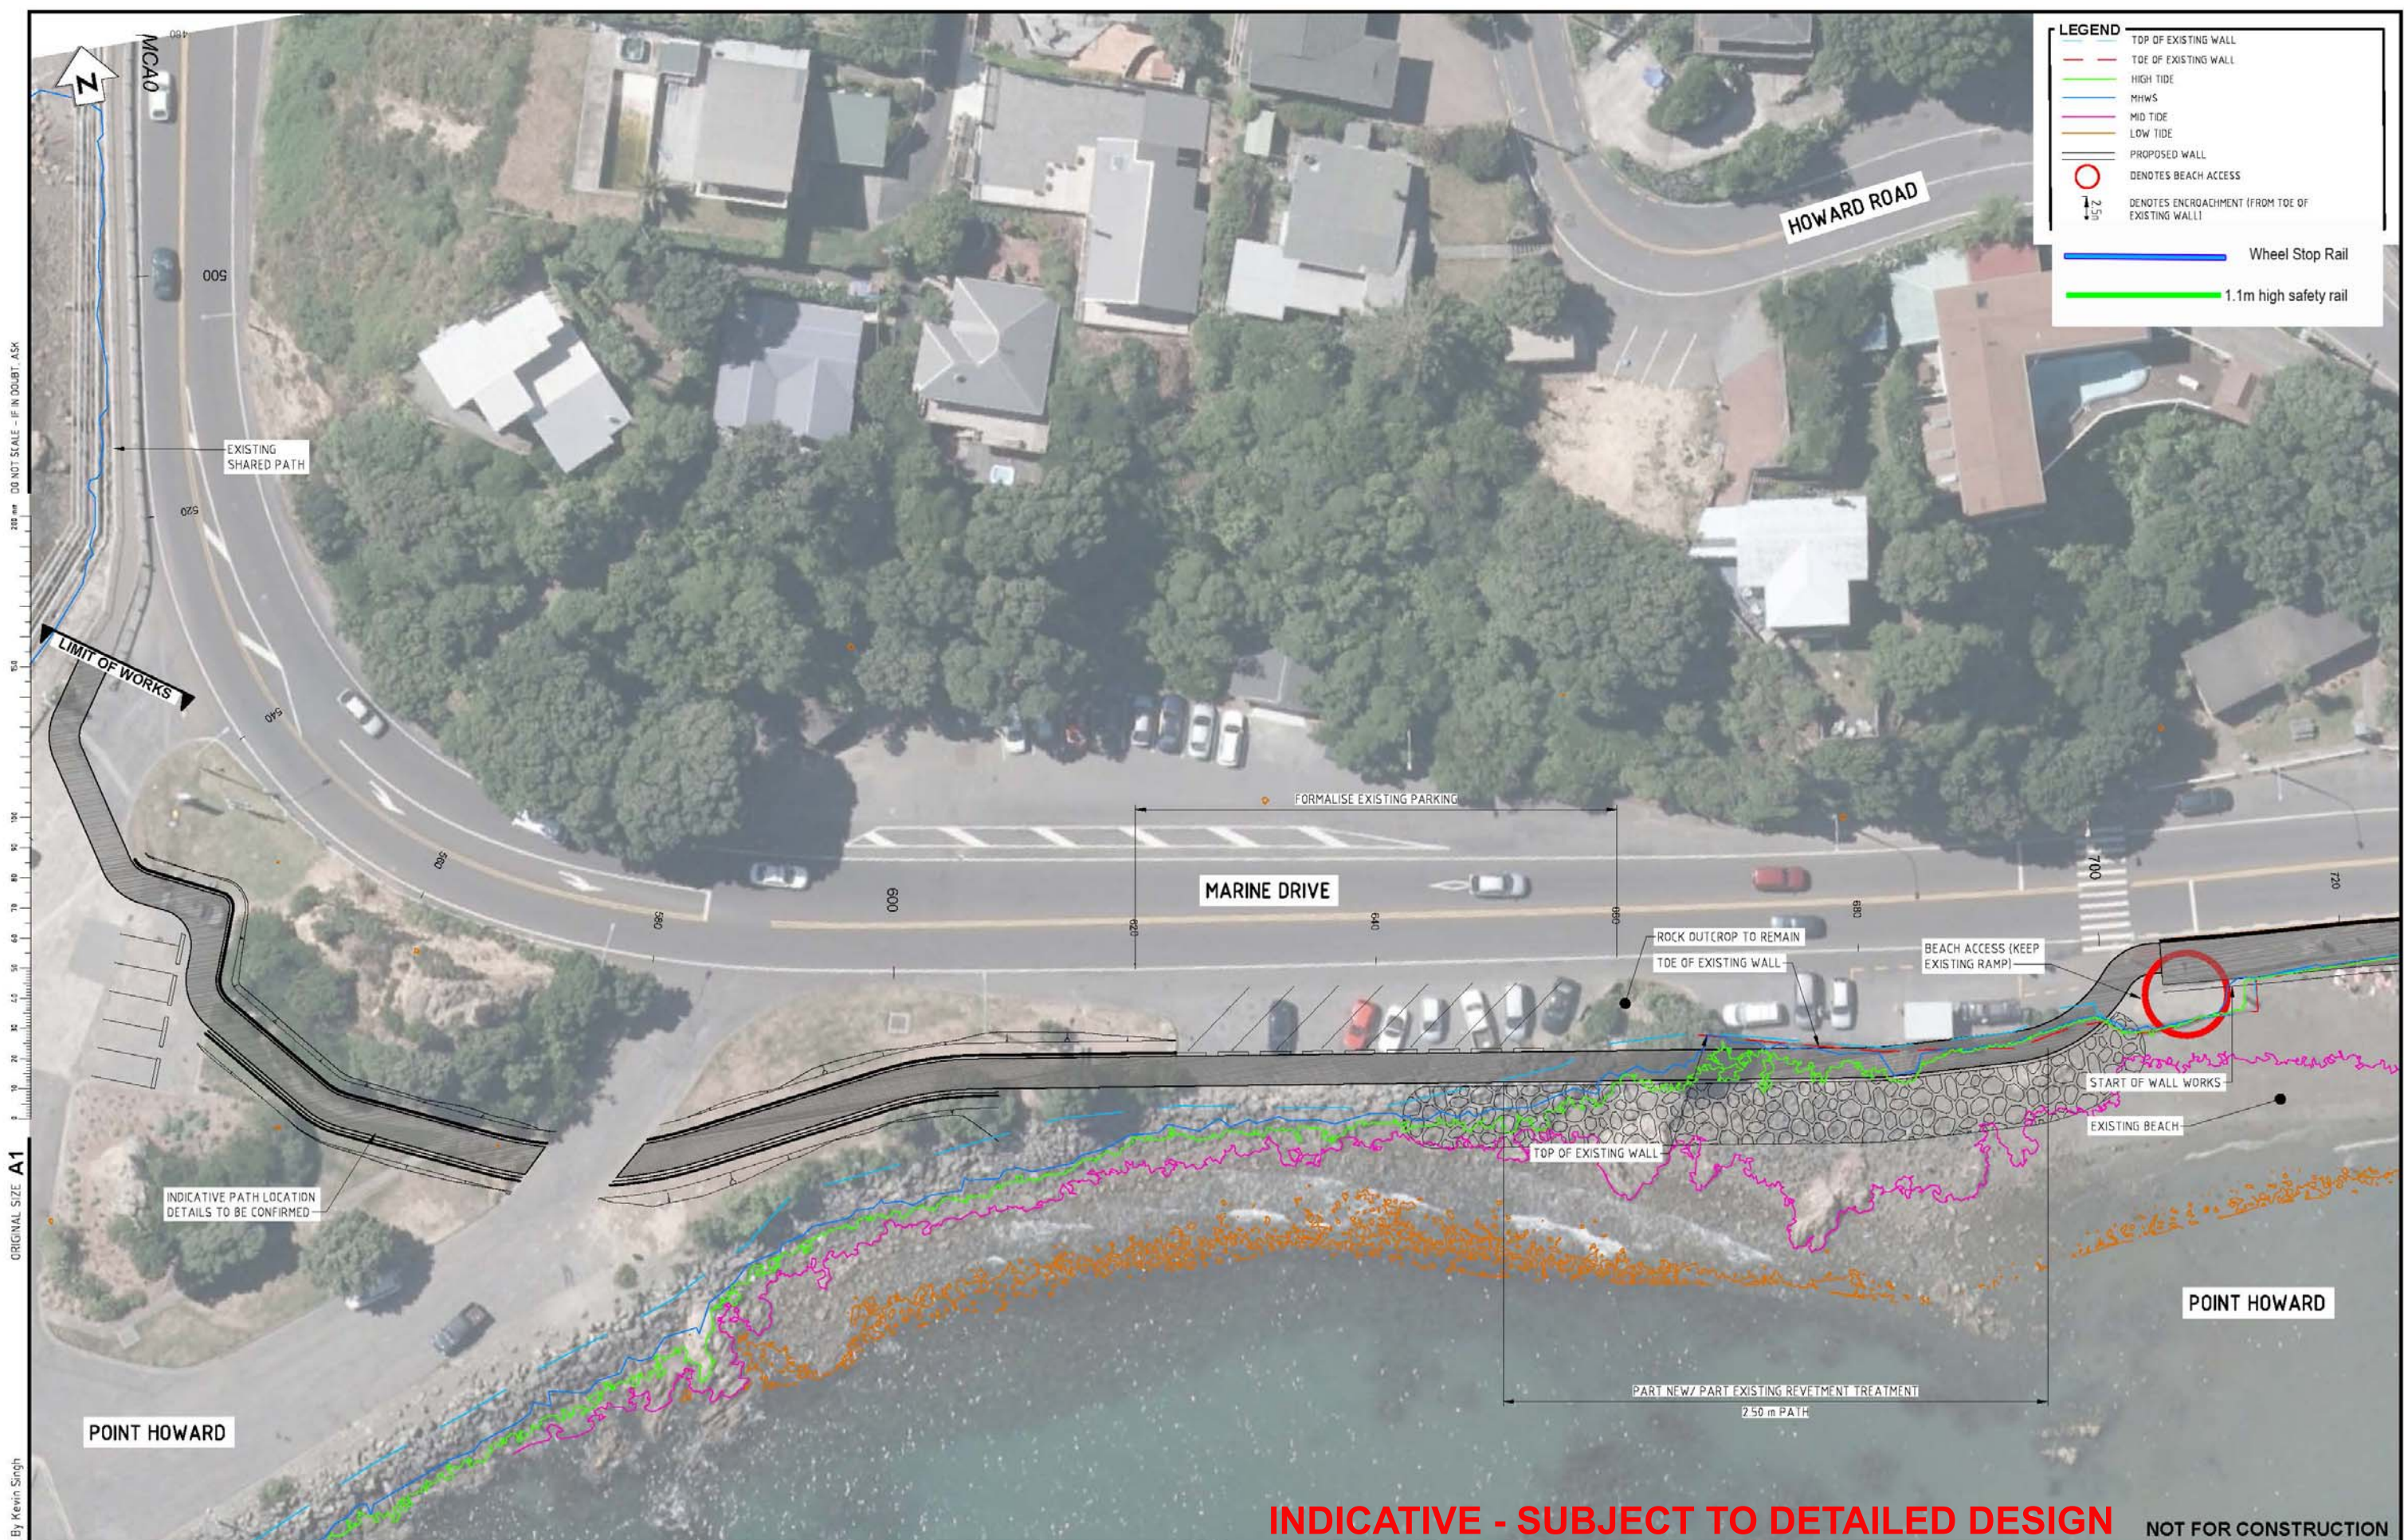

INDICATIVE - SUBJECT TO DETAILED DESIGN NOT FOR CONSTRUCTION

REV	DESCRIPTION	DESIGNED	DRAWN	CAD REVIEW	DESIGN CHECK	DESIGN REVIEW	APPROVED	PROF REGISTRATION
J	FOR CONSENT - ROCK REVETMENT REMOVED AND PATH WIDTH CHANGED	KVS	JP	08/18				
H	FOR CONSENT - MINOR AMENDMENT	KVS	JP	05/18				
G	FOR CONSENT	KVS	JP	04/18				
F	MINOR AMENDMENT	KVS	JP	05 03 2018				
E	MINOR AMENDMENT	KVS	JP	02 03 2018				
D	PRELIMINARY DESIGN	GC	JP	19 09 17				
C	FOR REVIEW - MANY SHEETS ADDED, MANY SHEETS RE-NUMBERED	PJ COOK	JP	08/17				
	REVISIONS	DRN	CHK	APP	DATE			

NOT APPROVED

HUTT CITY COUNCIL
EASTERN BAYS SHARED PATH - DBC


PLAN - MCA0
POINT HOWARD SORRENTO BAY STATION 480 - 720

Status Stamp	WORKING PLOT	
Date Stamp		
Scales	1 : 250 (A1)	
Drawing No	80509137-01-001-C220	Rev
		J


Last modified: Aug 24, 2018 By Kevin Singh

200 m DO NOT SCALE - IF IN DOUBT, ASK

ORIGINAL SIZE A1

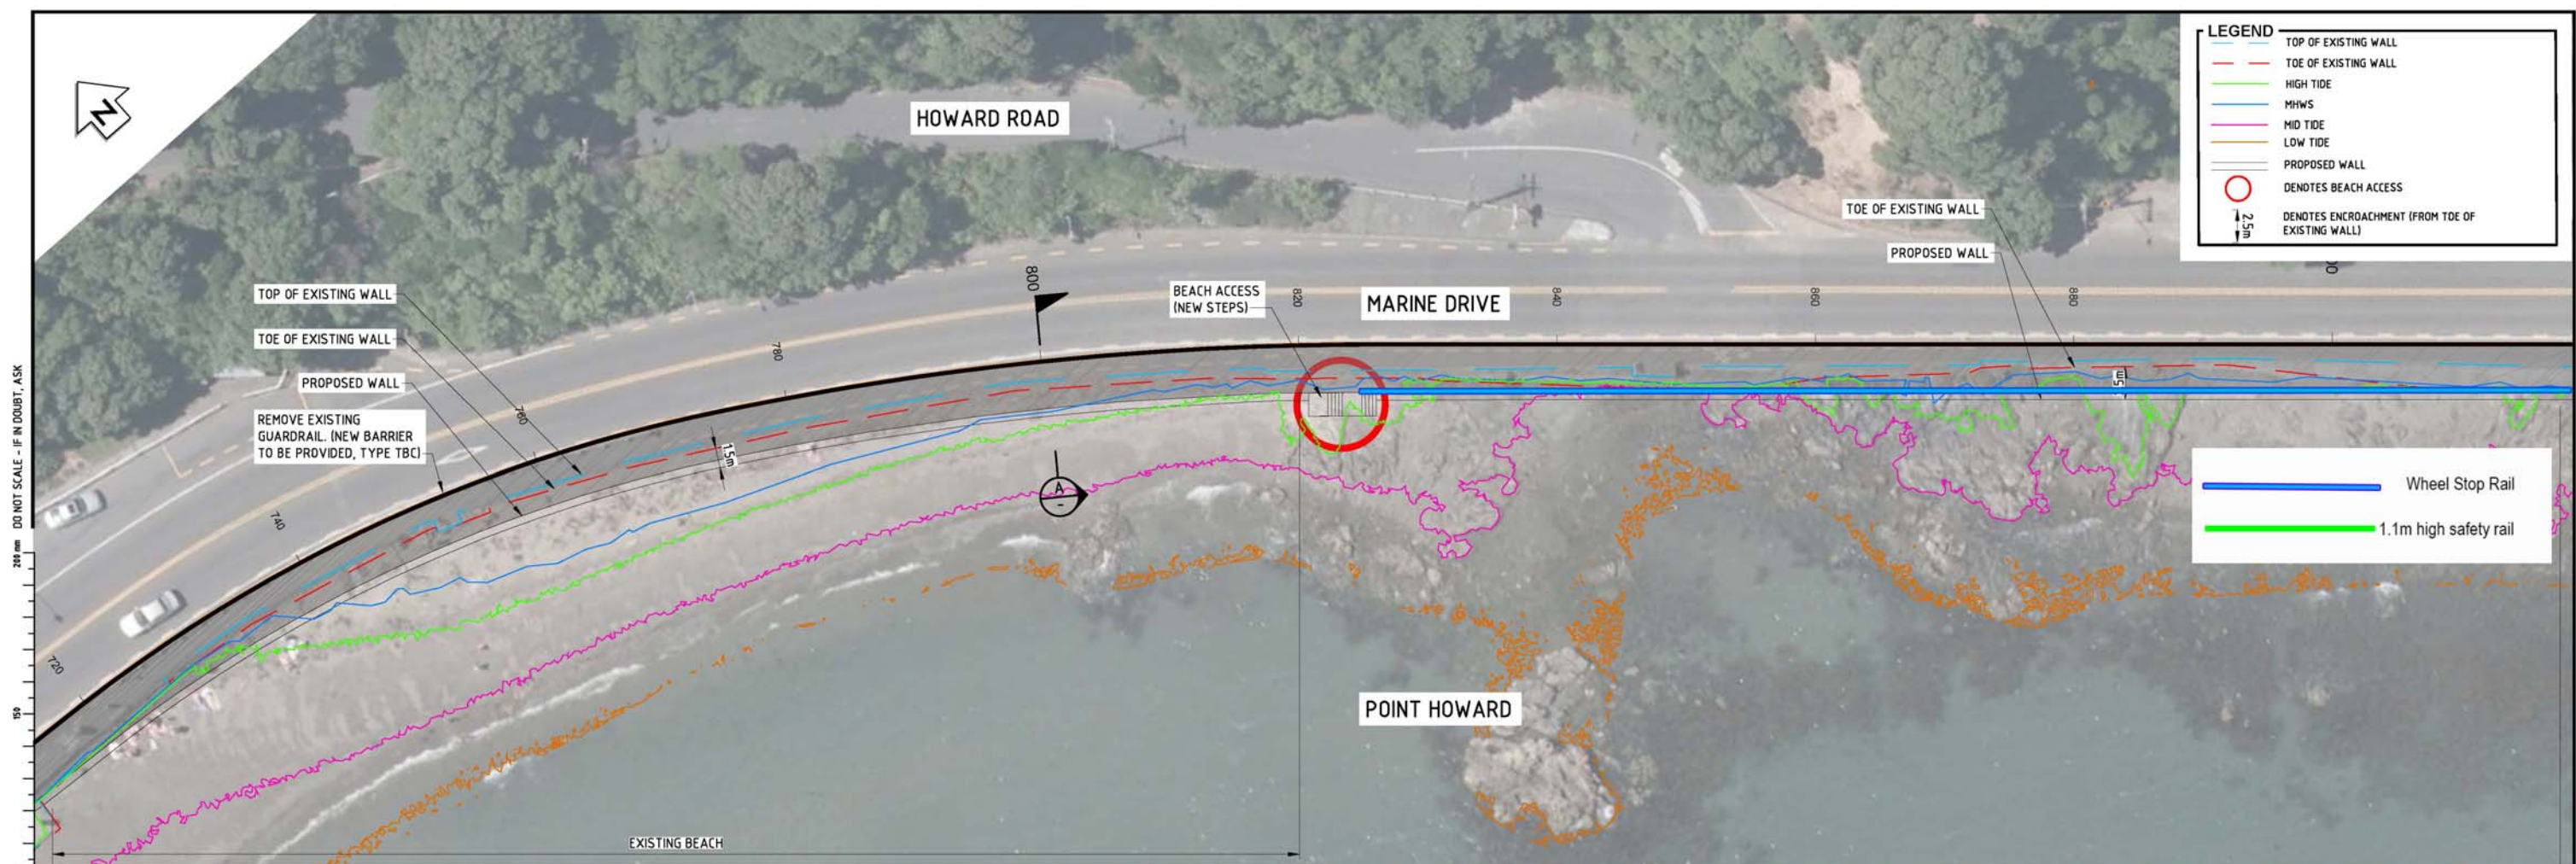

3.50 m PATH
DOUBLE CURVE SEA WALL

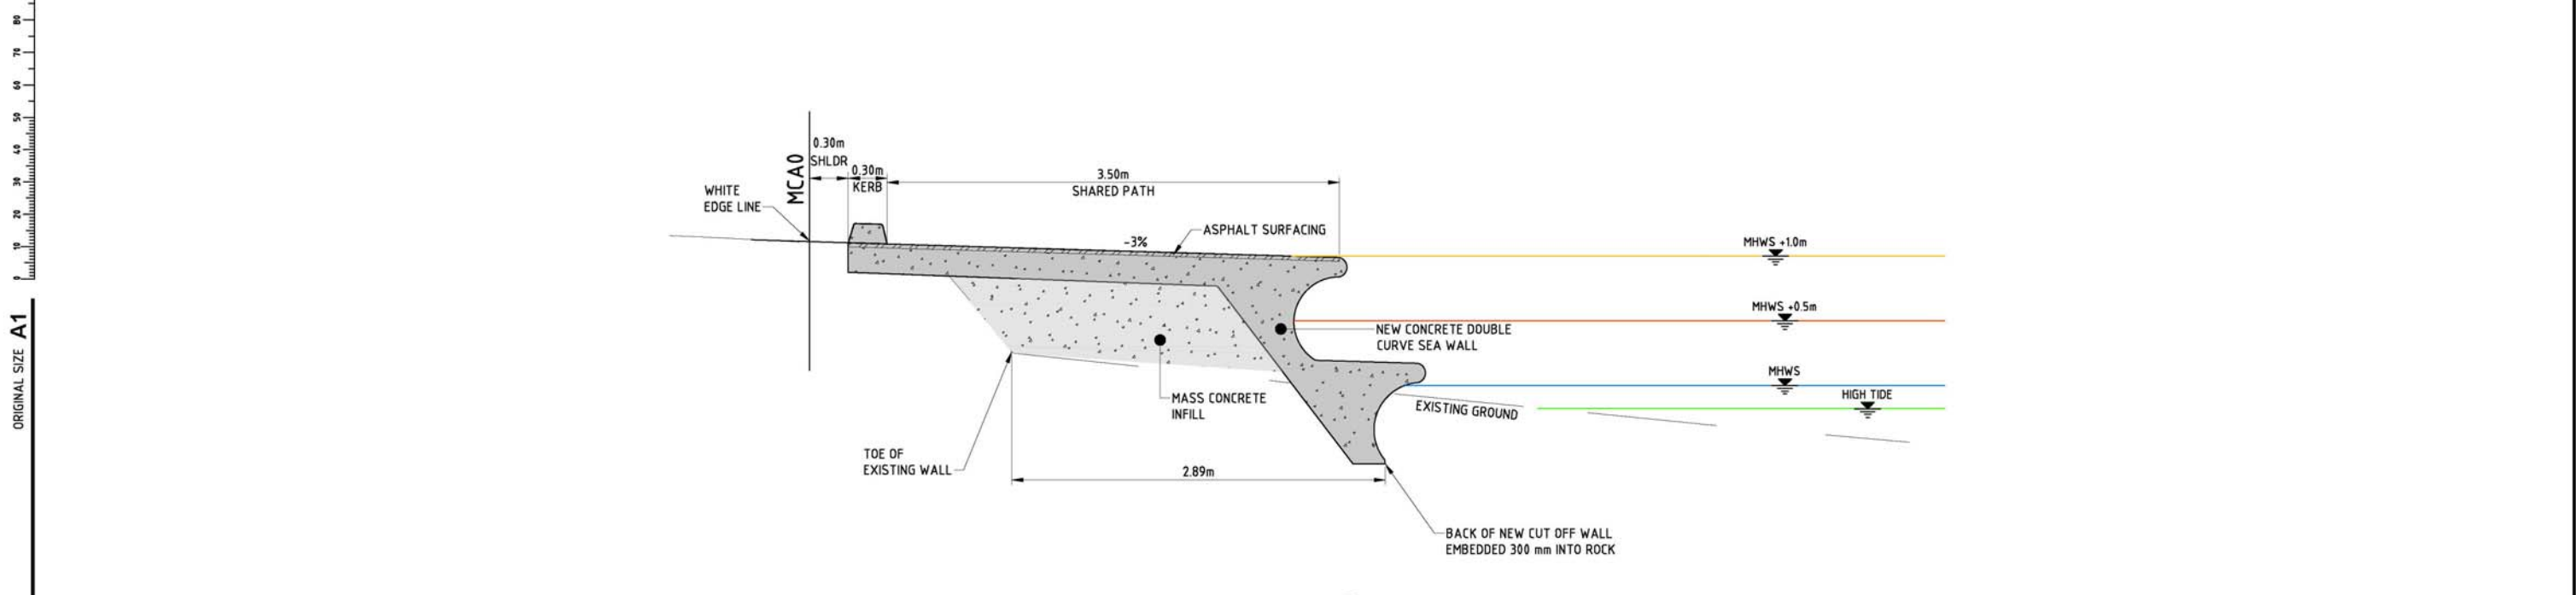

SECTION A
SCALE 1:25

INDICATIVE - SUBJECT TO DETAILED DESIGN

NOT FOR CONSTRUCTION

REV	DESCRIPTION	DRN	CHK	APP	DATE
J	FOR CONSENT - ROCK REVETMENT REMOVED AND PATH WIDTH CHANGED	KVS	JP		08/18
H	FOR CONSENT - MINOR AMENDMENT	KVS	JP		05/18
G	FOR CONSENT	KVS	JP		04/18
F	MINOR AMENDMENT	KVS	JP		09.03.2018
E	MINOR AMENDMENT	KVS	JP		02.03.2018
D	PRELIMINARY DESIGN	GC	JP		19.09.17
C	FOR REVIEW - MANY SHEETS ADDED, MANY SHEETS RE-NUMBERED	PJ COOK	JP		08/17
	REVISIONS				

SURVEYED	DESIGNED	DRAWN	CAD REVIEW	DESIGN CHECK	DESIGN REVIEW	APPROVED	PROF REGISTRATION:

NOT APPROVED

Client:

HUTT CITY COUNCIL
EASTERN BAYS SHARED PATH - DBC



PLAN - MCAO
POINT HOWARD SORRENTO BAY STATION 720 - 900

Status Stamp	WORKING PLOT
Date Stamp	
Scales	1:250 (A1)
Drawing No.	80509137-01-001-C221
Rev.	J

Last modified: Nov 23 2018 By Kevin Singh

DO NOT SCALE - IF IN DOUBT, ASK

ORIGINAL SIZE A1

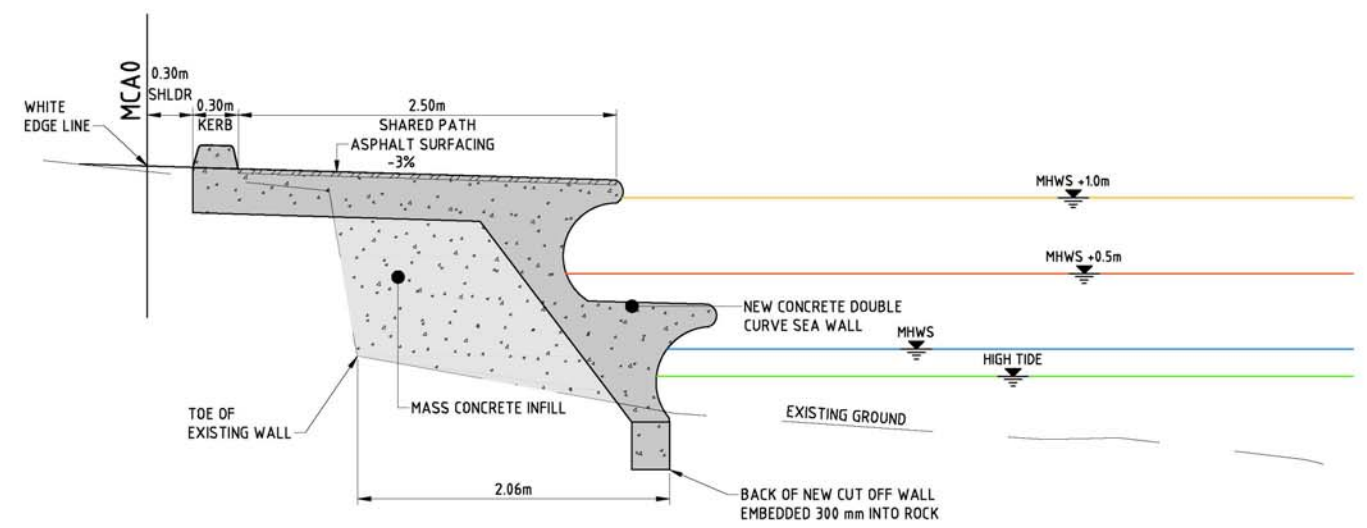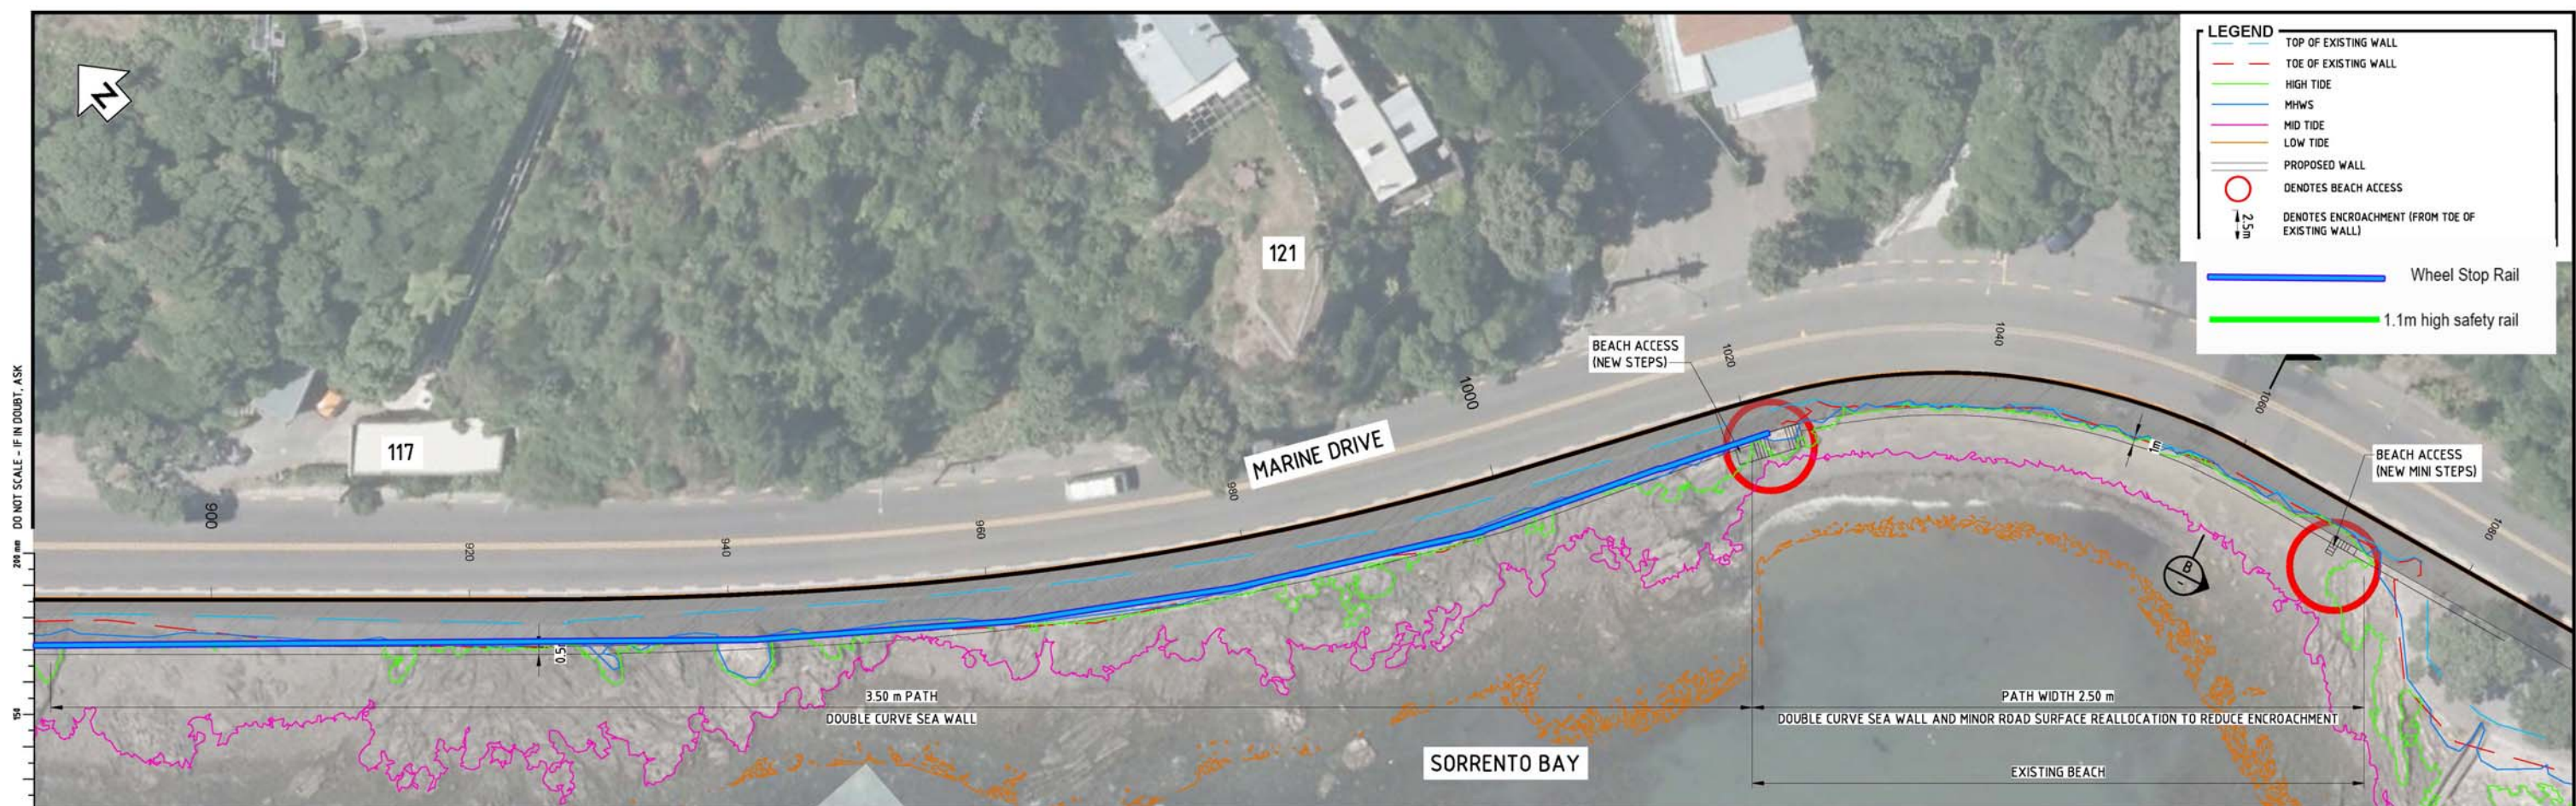

SECTION B
SCALE 1:25

INDICATIVE - SUBJECT TO DETAILED DESIGN

NOT FOR CONSTRUCTION

REV	DESCRIPTION	DRN	CHK	APP	DATE
J	FOR CONSENT - ROCK RETEVMENT REMOVED AND PATH WIDTH CHANGED	KVS	JP		08/18
H	FOR CONSENT - MINOR AMENDMENT	KVS	JP		05/18
G	FOR CONSENT	KVS	JP		04/18
F	MINOR AMENDMENT	KVS	JP		09.03.2018
E	MINOR AMENDMENT	KVS	JP		02.03.2018
D	PRELIMINARY DESIGN	GC	JP		19.09.17
C	FOR REVIEW - MANY SHEETS ADDED, MANY SHEETS RE-NUMBERED	PJ COOK	JP		08/17
	REVISIONS				

SURVEYED	DESIGNED	DRAWN	CAD REVIEW	DESIGN CHECK	DESIGN REVIEW	APPROVED	PROF REGISTRATION:

NOT APPROVED




HUTT CITY COUNCIL
EASTERN BAYS SHARED PATH - DBC
PLAN - MCA0
POINT HOWARD SORRENTO BAY STATION 900 - 1080

Status Stamp	WORKING PLOT
Date Stamp	
Scales	1:250 (A1)
Drawing No.	80509137-01-001-C222
Rev.	J

Last modified: Nov 23 2018 By Kevin Singh

ORIGINAL SIZE A1

DO NOT SCALE - IF IN DOUBT, ASK

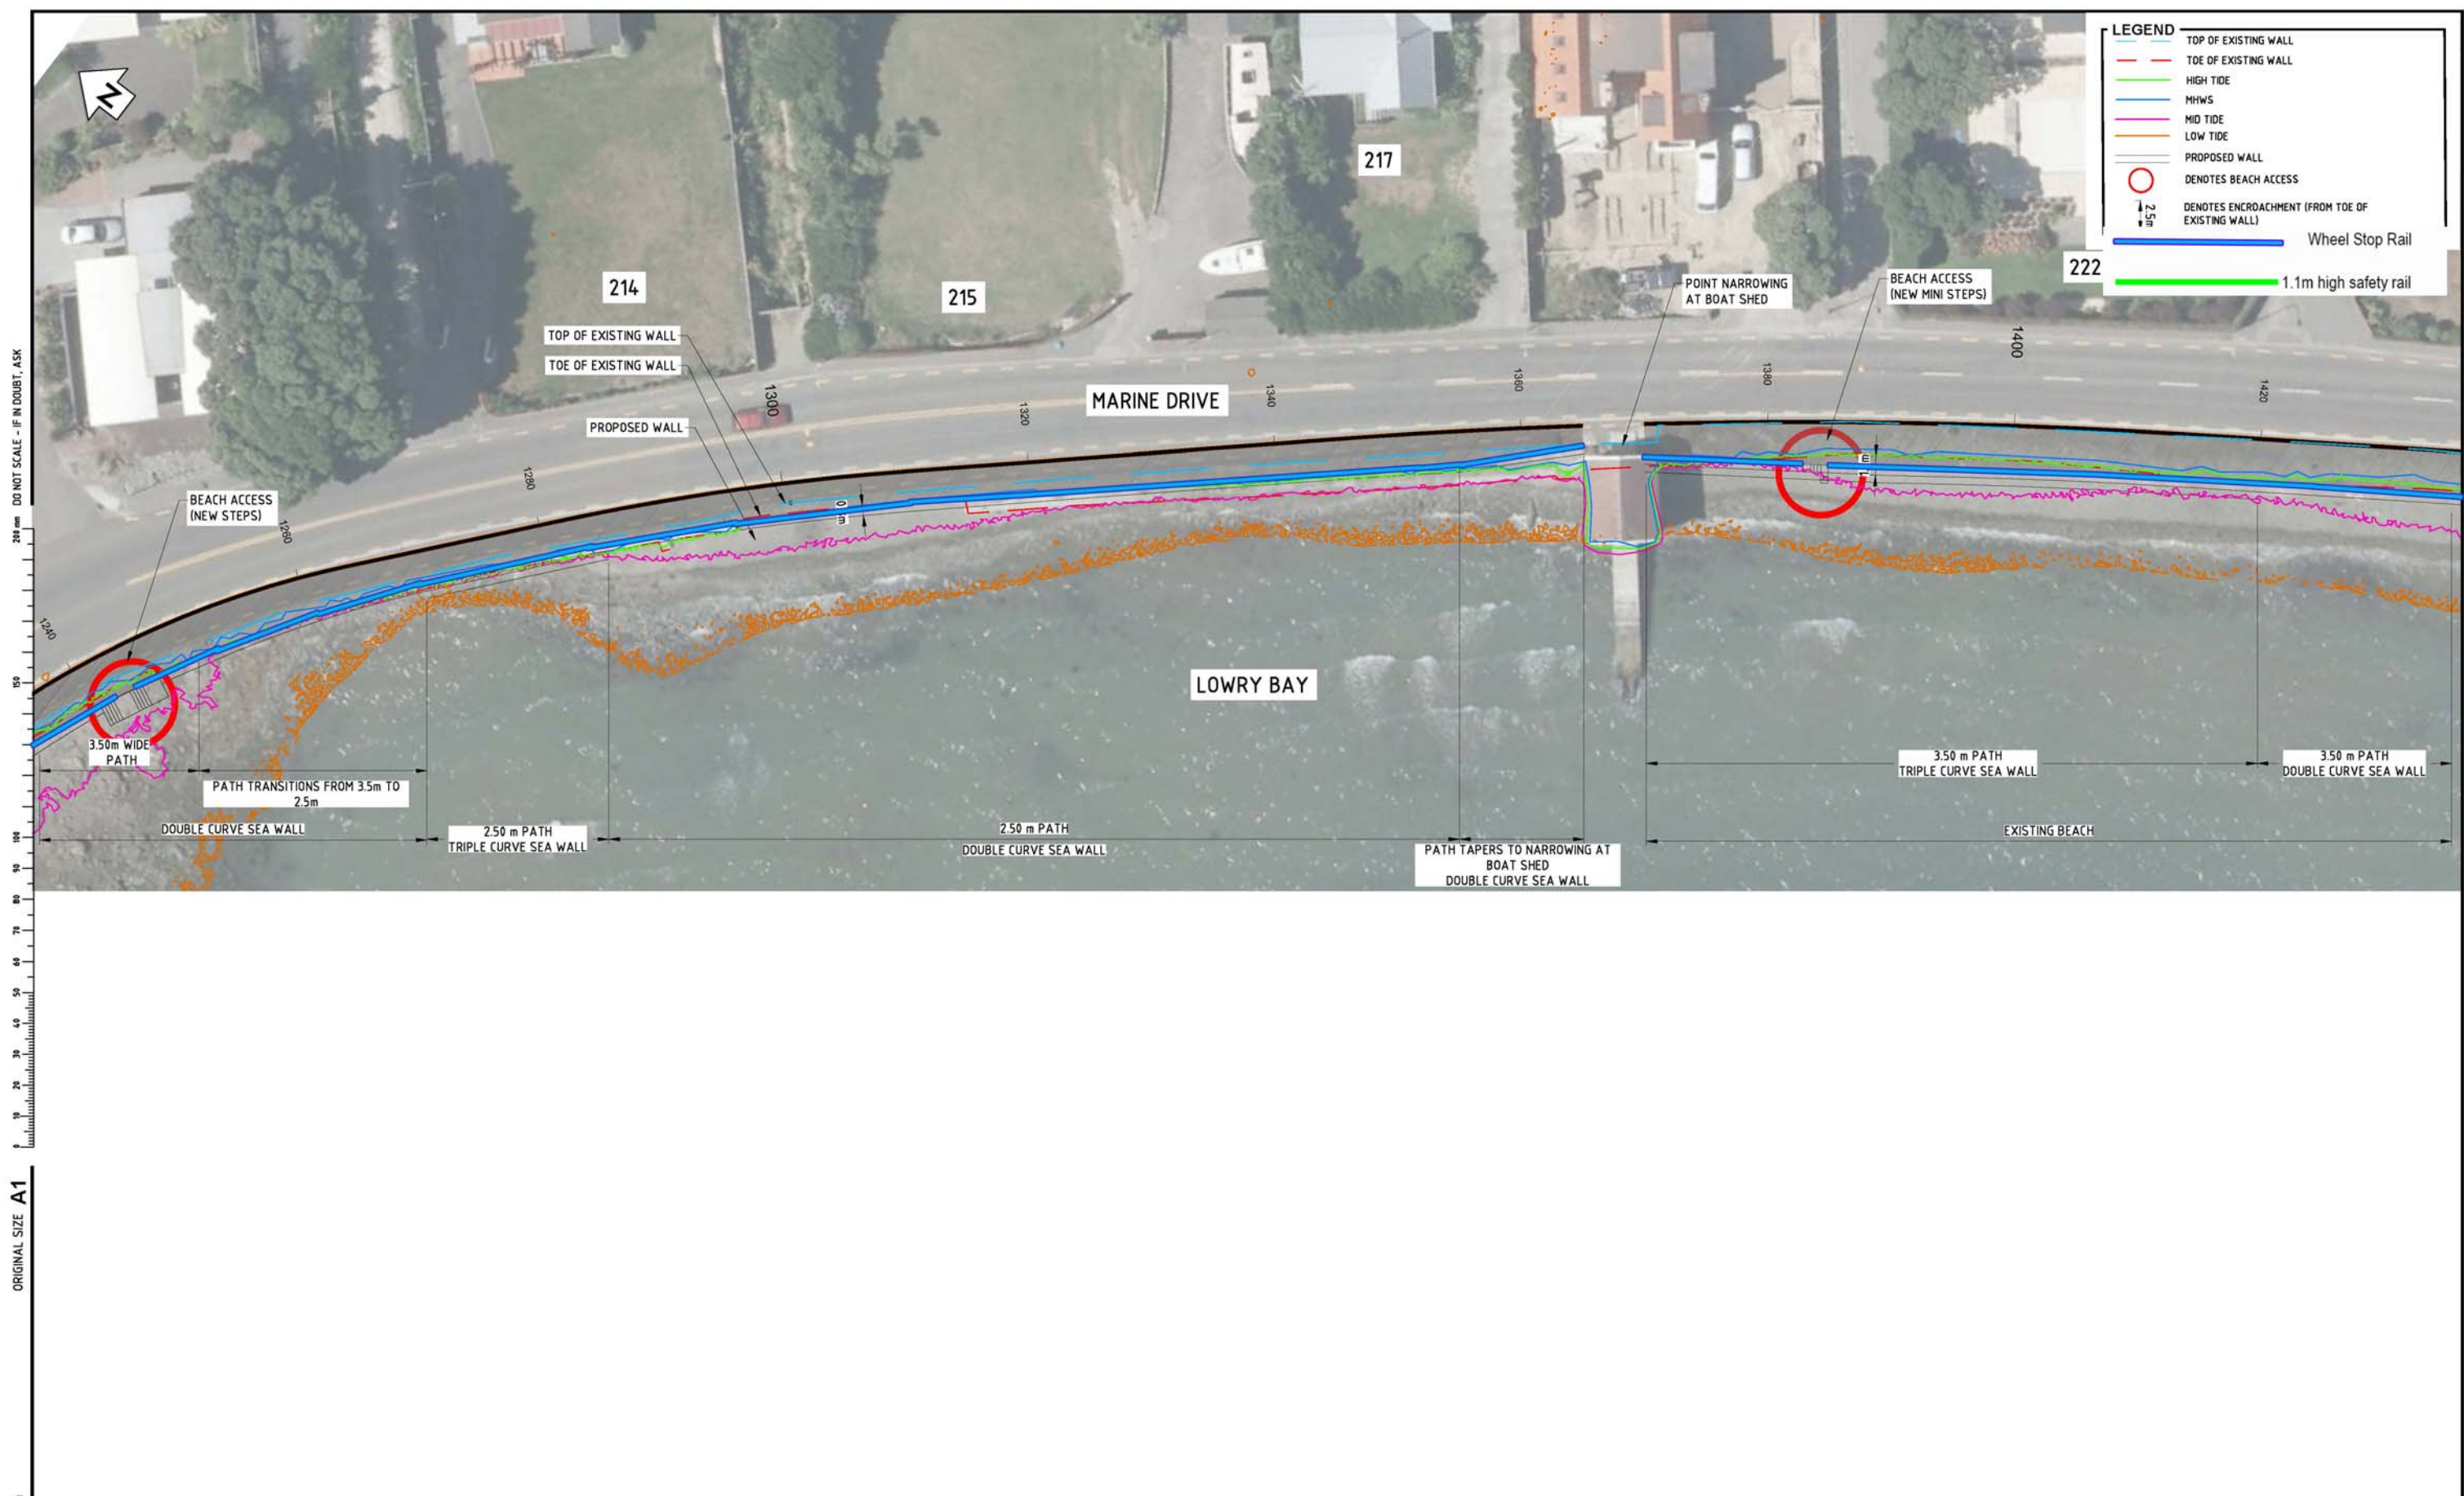

DO NOT SCALE - IF IN DOUBT, ASK

ORIGINAL SIZE A1

Last modified: Aug 27 2018 By Kevin Singh

INDICATIVE - SUBJECT TO DETAILED DESIGN NOT FOR CONSTRUCTION



REV	DESCRIPTION	DRN	CHK	APP	DATE
J	FOR CONSENT - ROCK REVETMENT REMOVED AND PATH WIDTH CHANGED	KVS	JP		08/18
H	FOR CONSENT - MINOR AMENDMENT	KVS	JP		05/18
G	FOR CONSENT	KVS	JP		04/18
F	MINOR AMENDMENT	KVS	JP		09.03.2018
E	MINOR AMENDMENT	KVS	JP		02.03.2018
D	PRELIMINARY DESIGN	GC	JP		19.09.17
C	FOR REVIEW - MANY SHEETS ADDED, MANY SHEETS RE-NUMBERED	PJ COOK	JP		08/17
	REVISIONS				

SURVEYED	DESIGNED	DRAWN	CAD REVIEW	DESIGN CHECK	DESIGN REVIEW	APPROVED	PROF REGISTRATION:
						NOT APPROVED	



Client: HUTT CITY COUNCIL
 EASTERN BAYS SHARED PATH - DBC
 PLAN - MCA0
 LOWRY BAY STATION 1240 - 1420

Status Stamp	WORKING PLOT
Date Stamp	
Scales	1 : 250
Drawing No.	80509137-01-001-C224
Rev.	J

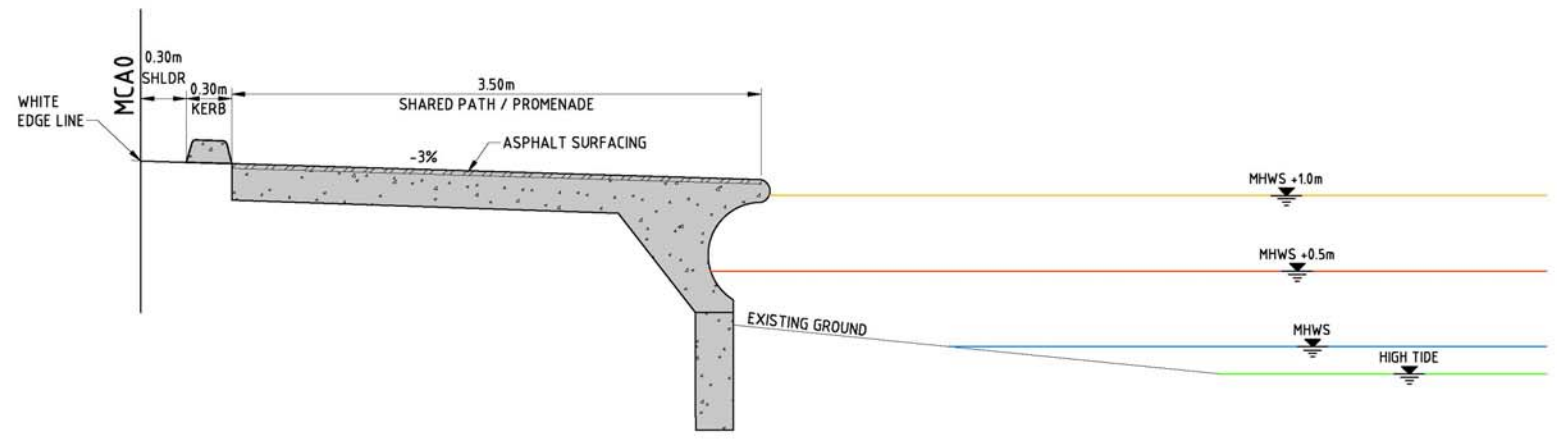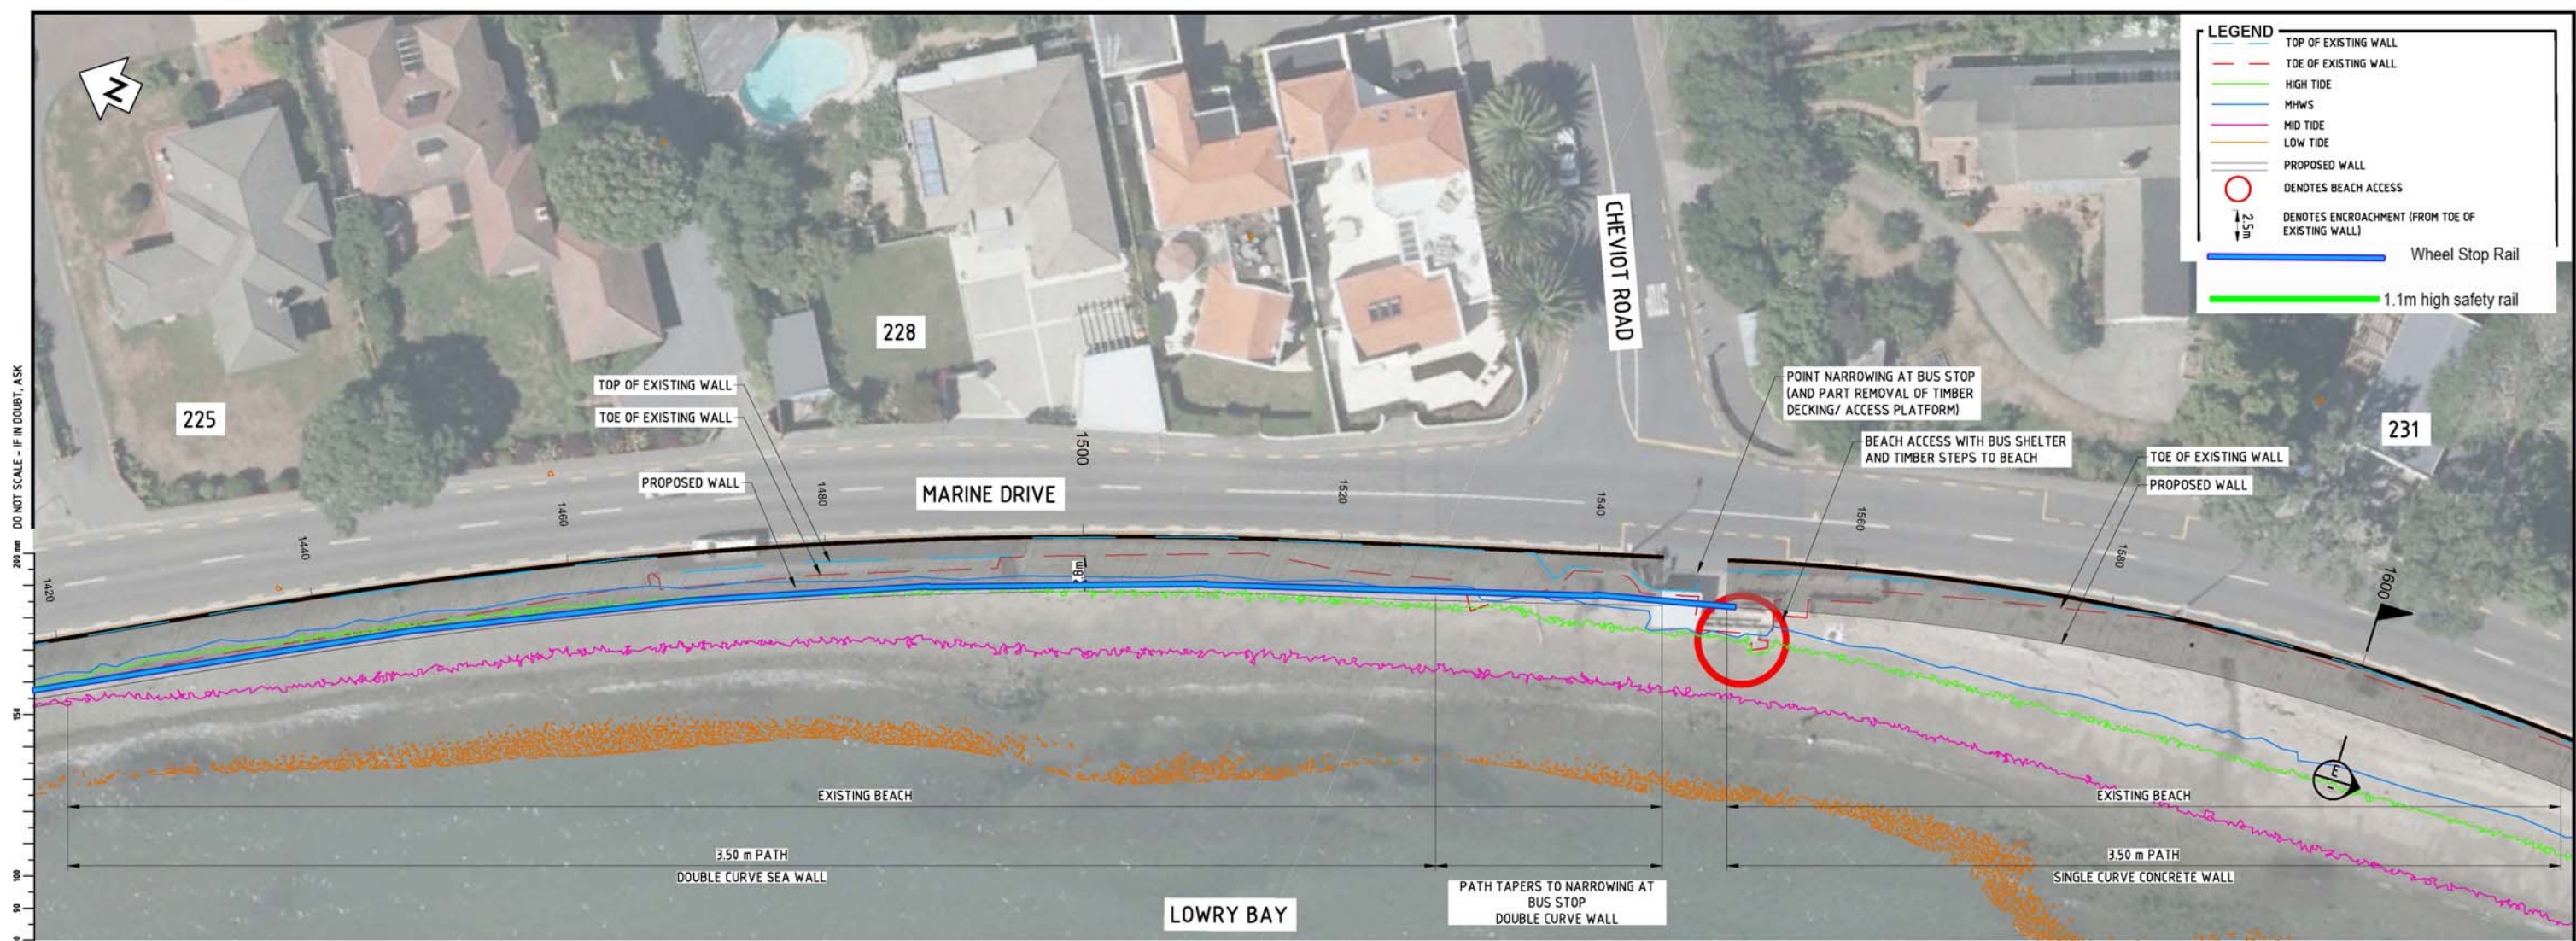

SECTION E
SCALE 1:25

INDICATIVE - SUBJECT TO DETAILED DESIGN NOT FOR CONSTRUCTION

ORIGINAL SIZE A1
Last modified: Nov 23 2018 By Kevin Singh

REV	DESCRIPTION	DRN	CHK	APP	DATE
J	FOR CONSENT - ROCK REVETMENT REMOVED AND PATH WIDTH CHANGED	KVS	JP		08/18
H	FOR CONSENT - MINOR AMENDMENT	KVS	JP		05/18
G	FOR CONSENT	KVS	JP		04/18
F	MINOR AMENDMENT	KVS	JP		09.03.2018
E	MINOR AMENDMENT	KVS	JP		02.03.2018
D	PRELIMINARY DESIGN	GC	JP		19.09.17
C	FOR REVIEW - MANY SHEETS ADDED, MANY SHEETS RE-NUMBERED	PJ COOK	JP		08/17
	REVISIONS				

SURVEYED	DESIGNED	DRAWN	CAD REVIEW	DESIGN CHECK	DESIGN REVIEW	APPROVED	PROF REGISTRATION:

NOT APPROVED


Client:

HUTT CITY COUNCIL
EASTERN BAYS SHARED PATH - DBC

PLAN - MCA0
LOWRY BAY STATION 1420 - 1600

Status Stamp	WORKING PLOT	
Date Stamp		
Scales	1 : 250	
Drawing No.	80509137-01-001-C225	Rev. J

LEGEND	
	TOP OF EXISTING WALL
	TOE OF EXISTING WALL
	HIGH TIDE
	MHWS
	MID TIDE
	LOW TIDE
	PROPOSED WALL
	DENOTES BEACH ACCESS
	DENOTES ENCROACHMENT (FROM TOE OF EXISTING WALL)
	Wheel Stop Rail
	1.1m high safety rail

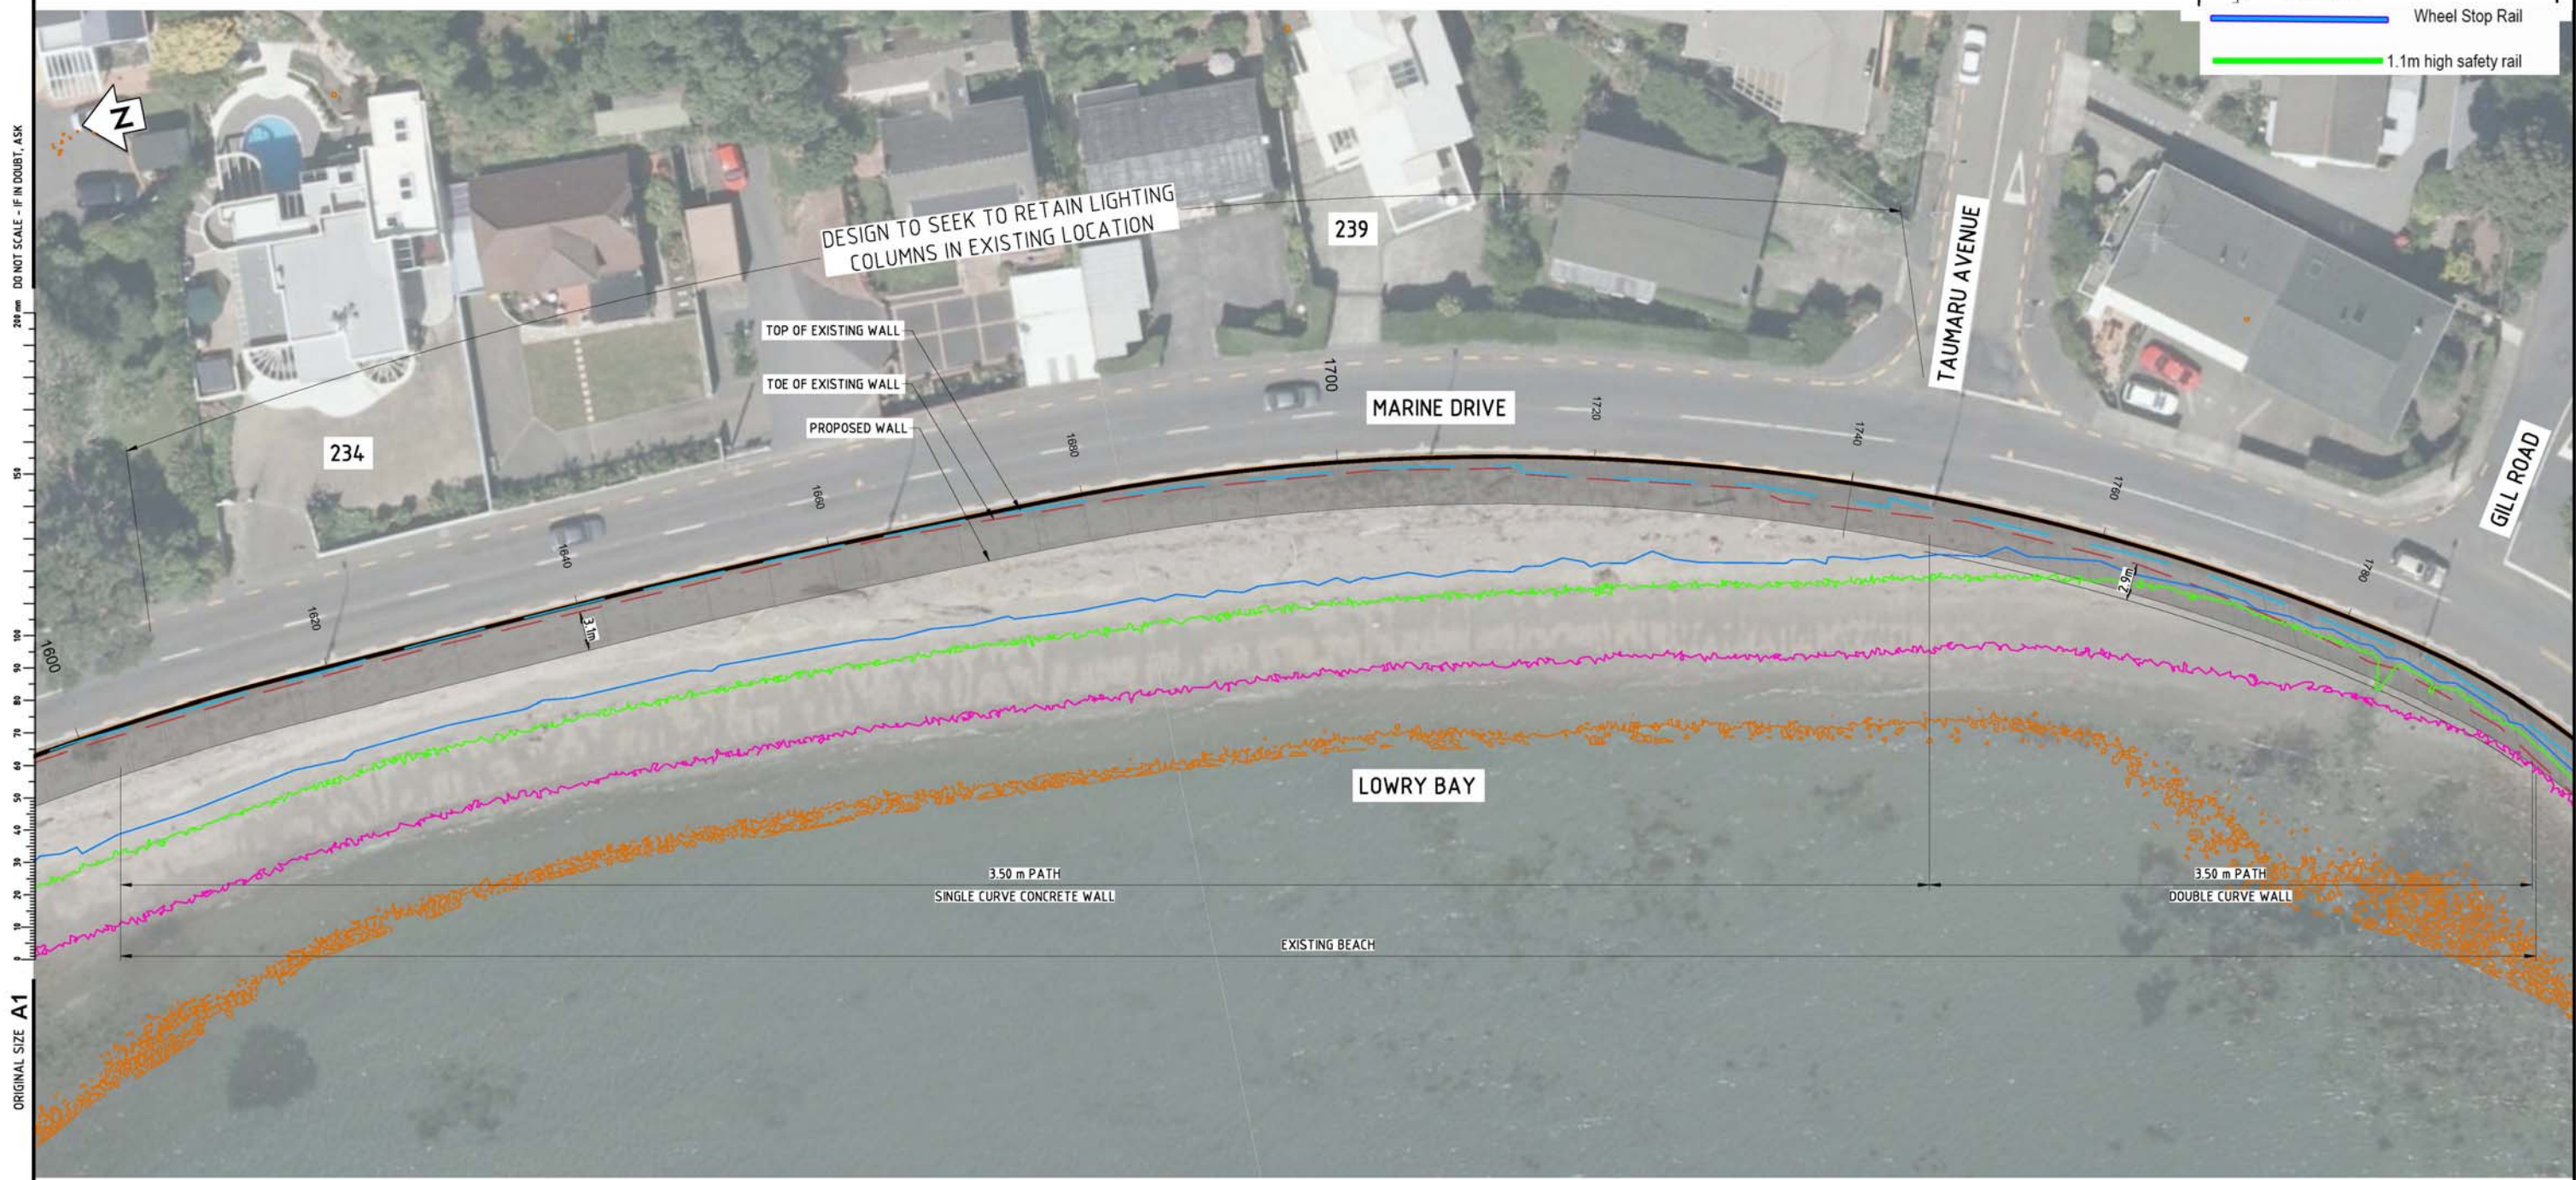

DESIGN TO SEEK TO RETAIN LIGHTING COLUMNS IN EXISTING LOCATION

TOP OF EXISTING WALL
TOE OF EXISTING WALL
PROPOSED WALL

MARINE DRIVE

TAUMARURU AVENUE

GILL ROAD

LOWRY BAY

3.50 m PATH
SINGLE CURVE CONCRETE WALL

3.50 m PATH
DOUBLE CURVE WALL

EXISTING BEACH

INDICATIVE - SUBJECT TO DETAILED DESIGN NOT FOR CONSTRUCTION

Last modified: Aug 26 2018 By Kevin Singh

REV	DESCRIPTION	DRN	CHK	APP	DATE
J	FOR CONSENT - ROCK REVETMENT REMOVED AND PATH WIDTH CHANGED	KVS	JP		08/18
H	FOR CONSENT - MINOR AMENDMENT	KVS	JP		05/18
G	FOR CONSENT	KVS	JP		04/18
F	MINOR AMENDMENT	KVS	JP		09.03.2018
E	MINOR AMENDMENT	KVS	JP		02.03.2018
D	PRELIMINARY DESIGN	GC	JP		19.09.17
C	FOR REVIEW - MANY SHEETS ADDED, MANY SHEETS RE-NUMBERED	PJ COOK	JP		08/17
	REVISIONS	DRN	CHK	APP	DATE


SURVEYED	
DESIGNED	
DRAWN	
CAD REVIEW	
DESIGN CHECK	
DESIGN REVIEW	NOT APPROVED
APPROVED	
PROF REGISTRATION:	

Client:

HUTT CITY COUNCIL
EASTERN BAYS SHARED PATH - DBC

PLAN - MCA0
LOWRY BAY STATION 1600 - 1780

Status Stamp	WORKING PLOT
Date Stamp	
Scales	1 : 250
Drawing No.	80509137-01-001-C226
Rev.	J

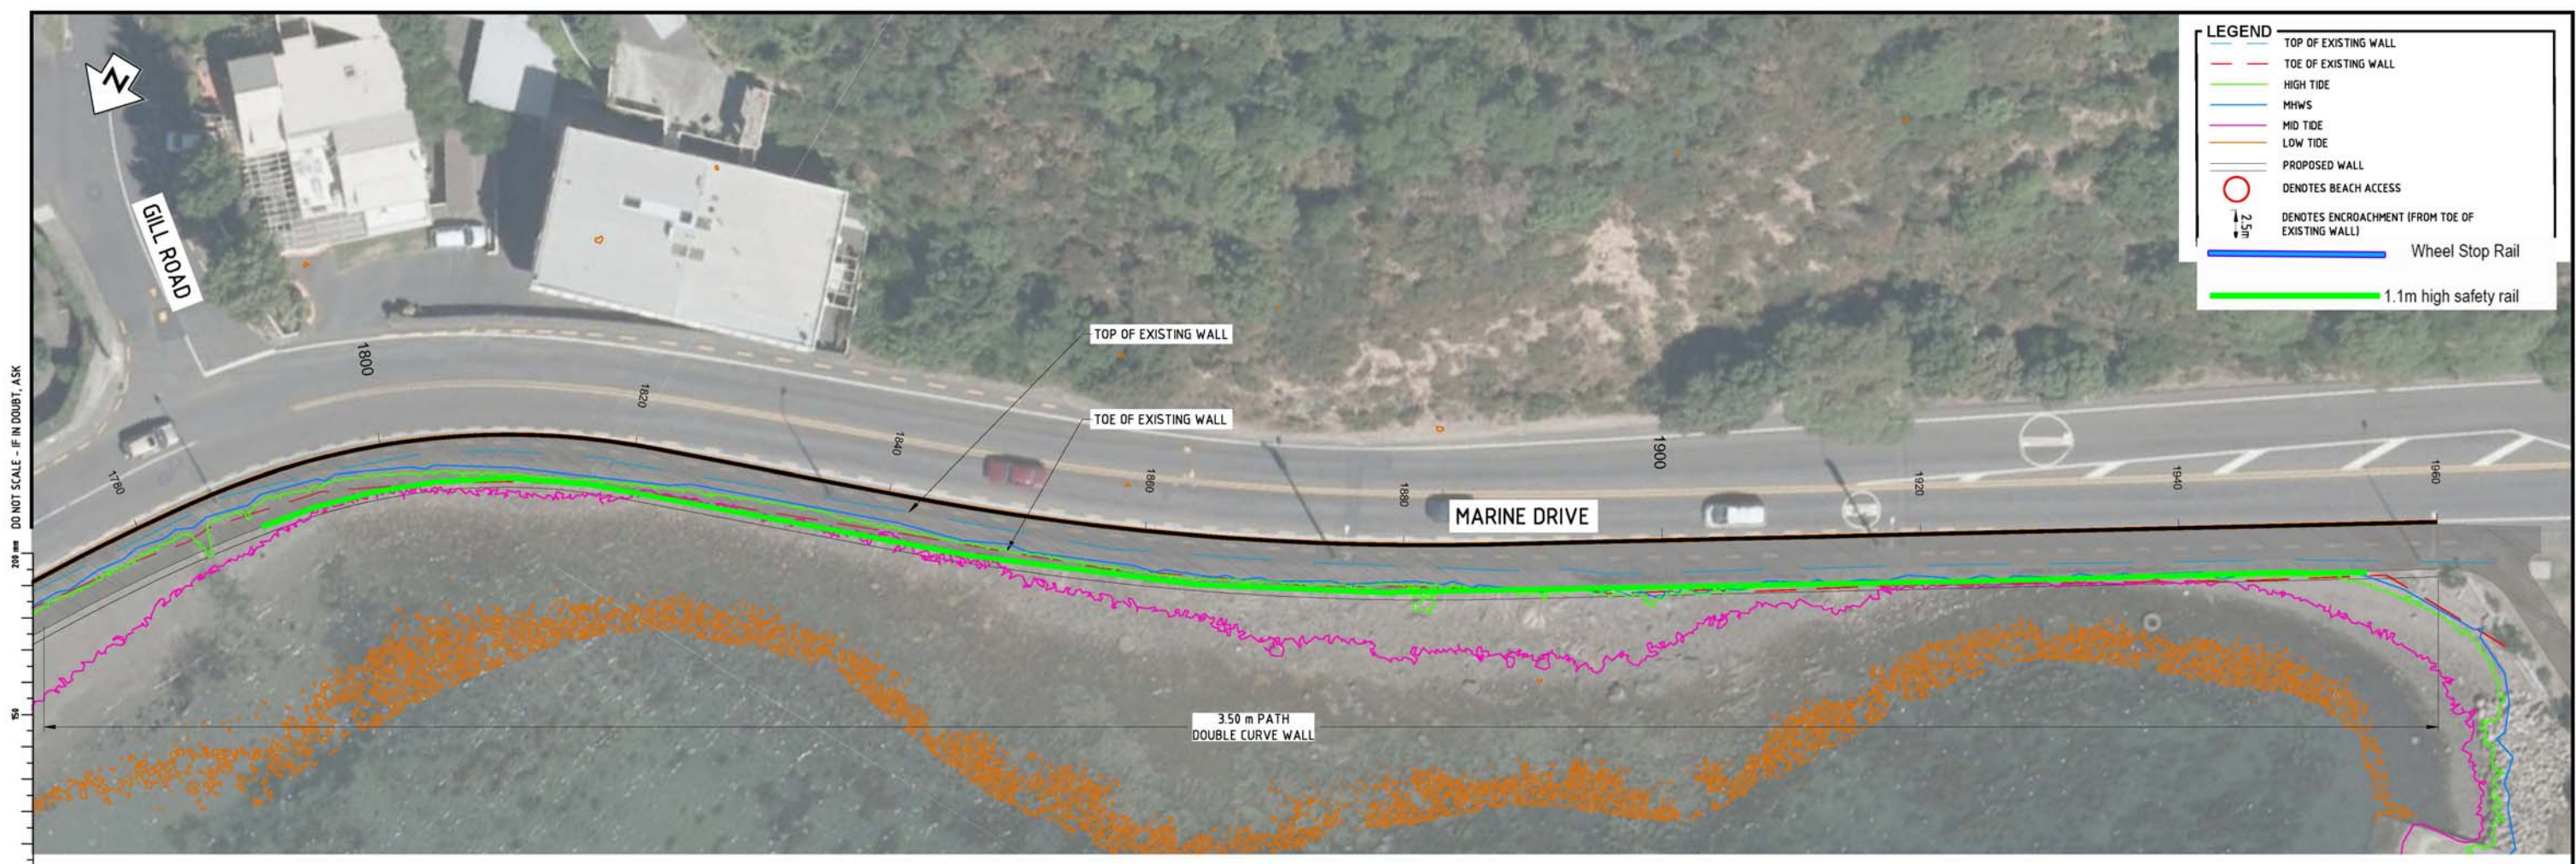

DO NOT SCALE - IF IN DOUBT, ASK

200 mm

ORIGINAL SIZE A1

Last modified: Aug 27 2018 By Kevin Singh

INDICATIVE - SUBJECT TO DETAILED DESIGN NOT FOR CONSTRUCTION

REV	DESCRIPTION	DRN	CHK	APP	DATE
J	FOR CONSENT - ROCK REVETMENT REMOVED AND PATH WIDTH CHANGED	KVS	JP		08/18
H	FOR CONSENT - MINOR AMENDMENT	KVS	JP		05/18
G	FOR CONSENT	KVS	JP		04/18
F	MINOR AMENDMENT	KVS	JP		09.03.2018
E	MINOR AMENDMENT	KVS	JP		02.03.2018
D	PRELIMINARY DESIGN	GC	JP		19.09.17
C	FOR REVIEW - MANY SHEETS ADDED, MANY SHEETS RE-NUMBERED	PJ COOK	JP		08/17
	REVISIONS				

SURVEYED	DESIGNED	DRAWN	CAD REVIEW	DESIGN CHECK	DESIGN REVIEW	APPROVED	PROF REGISTRATION



Client: HUTT CITY COUNCIL
EASTERN BAYS SHARED PATH - DBC
PLAN - MCA0
LOWRY BAY - YORK BAY STATION 1780 - 1960

Status Stamp	WORKING PLOT	
Date Stamp		
Scales	AS SHOWN	
Drawing No.	80509137-01-001-C227	Rev. J

LEGEND	
	TOP OF EXISTING WALL
	TOE OF EXISTING WALL
	HIGH TIDE
	MHWS
	MID TIDE
	LOW TIDE
	PROPOSED WALL
	DENOTES BEACH ACCESS
	DENOTES ENCROACHMENT (FROM TOE OF EXISTING WALL)
	Wheel Stop Rail
	1.1m high safety rail



ORIGINAL SIZE A1
DO NOT SCALE - IF IN DOUBT, ASK

INDICATIVE - SUBJECT TO DETAILED DESIGN NOT FOR CONSTRUCTION

REV	DESCRIPTION	DRN	CHK	APP	DATE
J	FOR CONSENT - ROCK RETEVMENT REMOVED AND PATH WIDTH CHANGED	KVS	JP		08/18
H	FOR CONSENT - MINOR AMENDMENT	KVS	JP		05/18
G	FOR CONSENT	KVS	JP		04/18
F	MINOR AMENDMENT	KVS	JP		09.03.2018
E	MINOR AMENDMENT	KVS	JP		02.03.2018
D	PRELIMINARY DESIGN	GC	JP		19.09.17
C	FOR REVIEW - MANY SHEETS ADDED, MANY SHEETS RE-NUMBERED	PJ COOK	JP		08/17
	REVISIONS				

SURVEYED	
DESIGNED	
DRAWN	
CAD REVIEW	
DESIGN CHECK	
DESIGN REVIEW	
APPROVED	NOT APPROVED
PROF REGISTRATION:	


Client:

HUTT CITY COUNCIL
EASTERN BAYS SHARED PATH - DBC

PLAN - MCA0
LOWRY BAY TO YORK BAY STATION 1960 - 2140

Status Stamp	WORKING PLOT
Date Stamp	
Scales	AS SHOWN
Drawing No.	80509137-01-001-C228
Rev.	J

Last modified: Aug 26 2018 By Kevin Singh

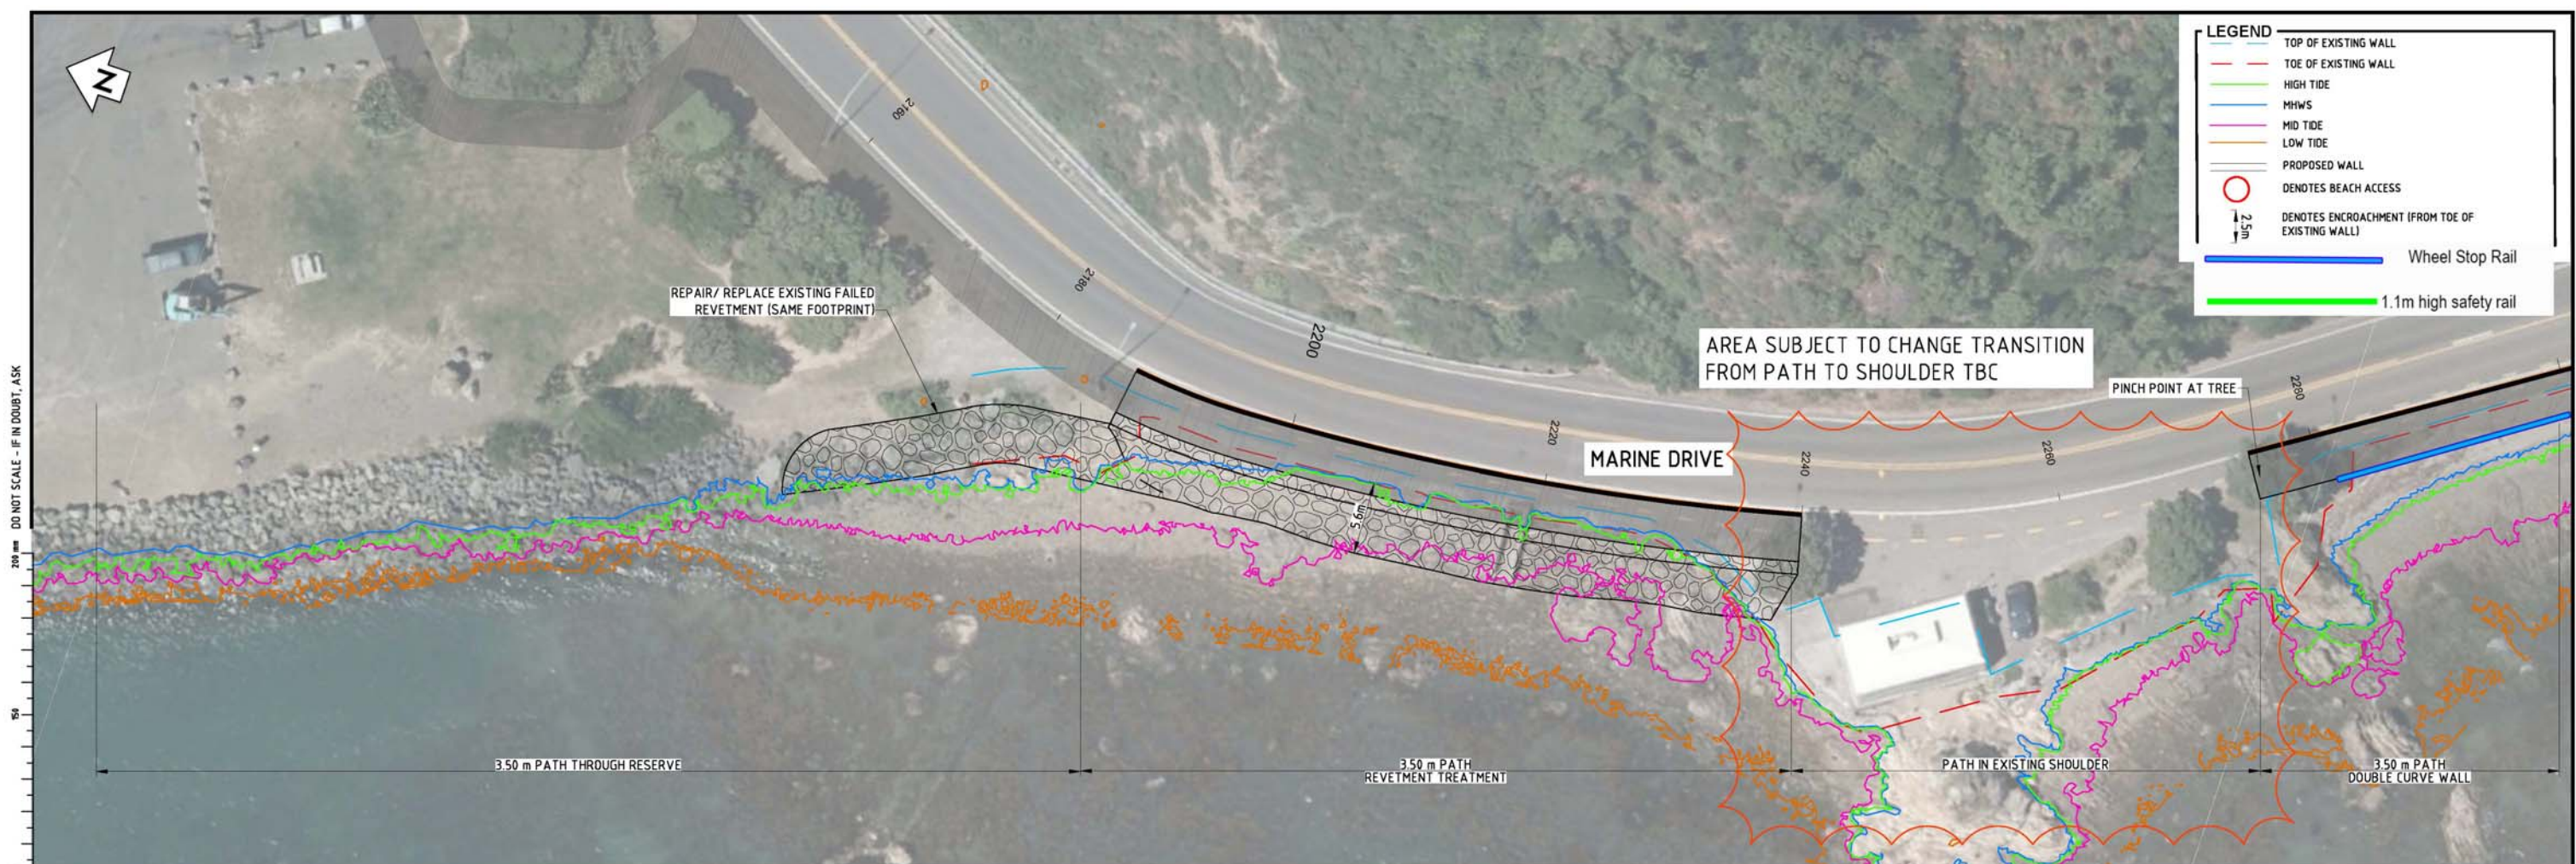

DO NOT SCALE - IF IN DOUBT, ASK

ORIGINAL SIZE A1

Last modified: Aug 24, 2018 By Kevin Singh

INDICATIVE - SUBJECT TO DETAILED DESIGN NOT FOR CONSTRUCTION

REV	DESCRIPTION	DRN	CHK	APP	DATE
J	FOR CONSENT - ROCK REVELMENT REMOVED AND PATH WIDTH CHANGED	KVS	JP		08/18
H	FOR CONSENT - MINOR AMENDMENT	KVS	JP		05/18
G	FOR CONSENT	KVS	JP		04/18
F	MINOR AMENDMENT	KVS	JP		09.03.2018
E	MINOR AMENDMENT	KVS	JP		02.03.2018
D	PRELIMINARY DESIGN	GC	JP		19.09.17
C	FOR REVIEW - MANY SHEETS ADDED, MANY SHEETS RE-NUMBERED	PJ COOK	JP		08/17



SURVEYED	DESIGNED	DRAWN	CAD REVIEW	DESIGN CHECK	DESIGN REVIEW	APPROVED	PROF REGISTRATION
						NOT APPROVED	



HUTT CITY COUNCIL
EASTERN BAYS SHARED PATH - DBC

PLAN - MCA0
LOWRY BAY TO YORK BAY STATION 2140 - 2300

Status Stamp	WORKING PLOT	
Date Stamp		
Scales	AS SHOWN	
Drawing No.	80509137-01-001-C229	Rev. J

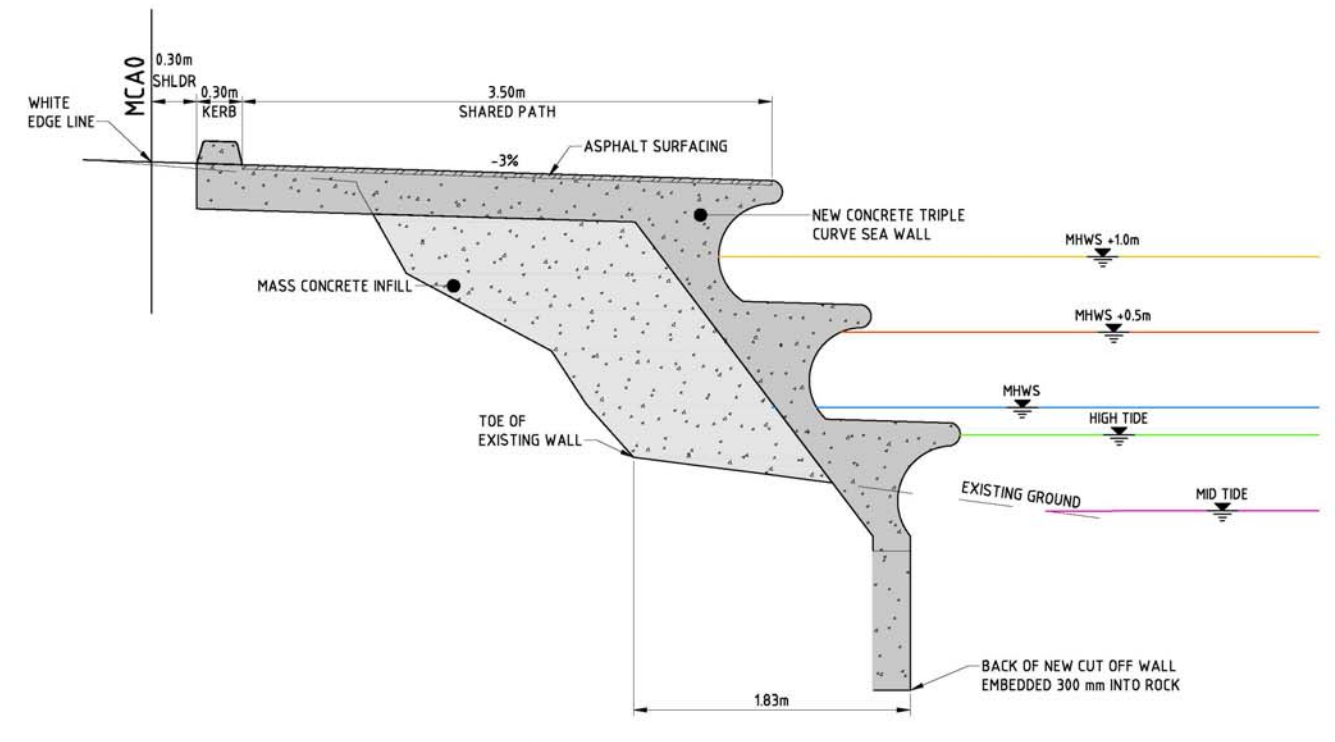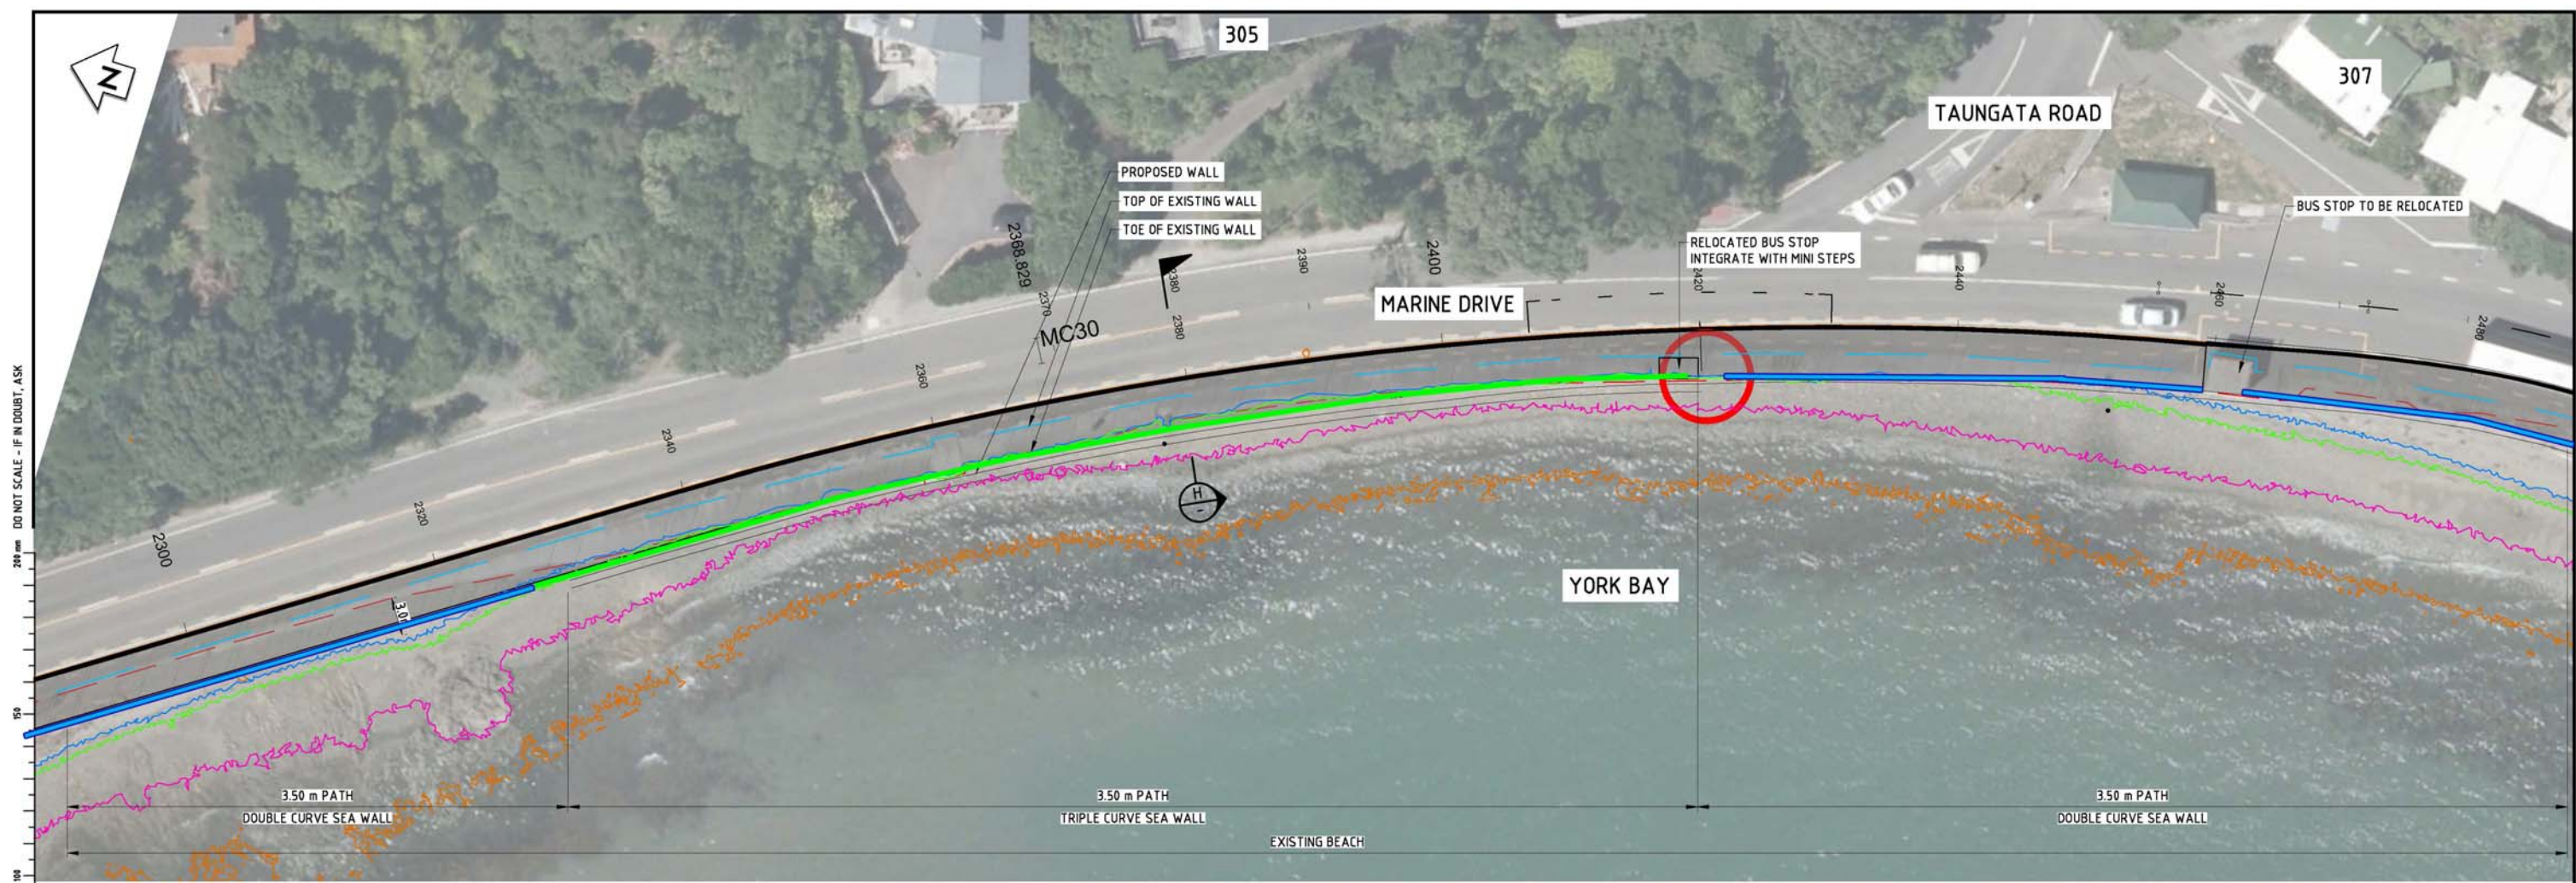

SECTION H
SCALE 1: 25

INDICATIVE - SUBJECT TO DETAILED DESIGN NOT FOR CONSTRUCTION

LEGEND

- TOP OF EXISTING WALL
- TOE OF EXISTING WALL
- HIGH TIDE
- MHWS
- MID TIDE
- LOW TIDE
- PROPOSED WALL
- DENOTES BEACH ACCESS
- DENOTES ENCROACHMENT (FROM TOE OF EXISTING WALL)
- 2.5m
- Wheel Stop Rail
- 1.1m high safety rail

REV	DESCRIPTION	DRN	CHK	APP	DATE	SURVEYED	DESIGNED	DRAWN	CAD REVIEW	DESIGN CHECK	DESIGN REVIEW	APPROVED	PROF REGISTRATION:
J	FOR CONSENT - ROCK REVELMENT REMOVED AND PATH WIDTH CHANGED					KVS	JP	08/18					
H	FOR CONSENT - MINOR AMENDMENT					KVS	JP	05/18					
G	FOR CONSENT					KVS	JP	04/18					
F	MINOR AMENDMENT					KVS	JP	09.03.2018					
E	MINOR AMENDMENT					KVS	JP	02.03.2018					
D	PRELIMINARY DESIGN					GC	JP	19.09.17					
C	FOR REVIEW - MANY SHEETS ADDED, MANY SHEETS RE-NUMBERED					PJ COOK	JP	08/17					
REV	REVISIONS												

HUTT CITY COUNCIL
EASTERN BAYS SHARED PATH - DBC

PLAN - MCA0
YORK BAY STATION 2300 - 2480

Status Stamp: **WORKING PLOT**

Date Stamp:


Scales 1: 250

Drawing No. 80509137-01-001-C230

Rev. J

Last modified: Nov 23 2018 By: Kevin Singh

LEGEND	
	TOP OF EXISTING WALL
	TOE OF EXISTING WALL
	HIGH TIDE
	MHWS
	MID TIDE
	LOW TIDE
	PROPOSED WALL
	DENOTES BEACH ACCESS
	DENOTES ENCROACHMENT (FROM TOE OF EXISTING WALL)
	Wheel Stop Rail
	1.1m high safety rail

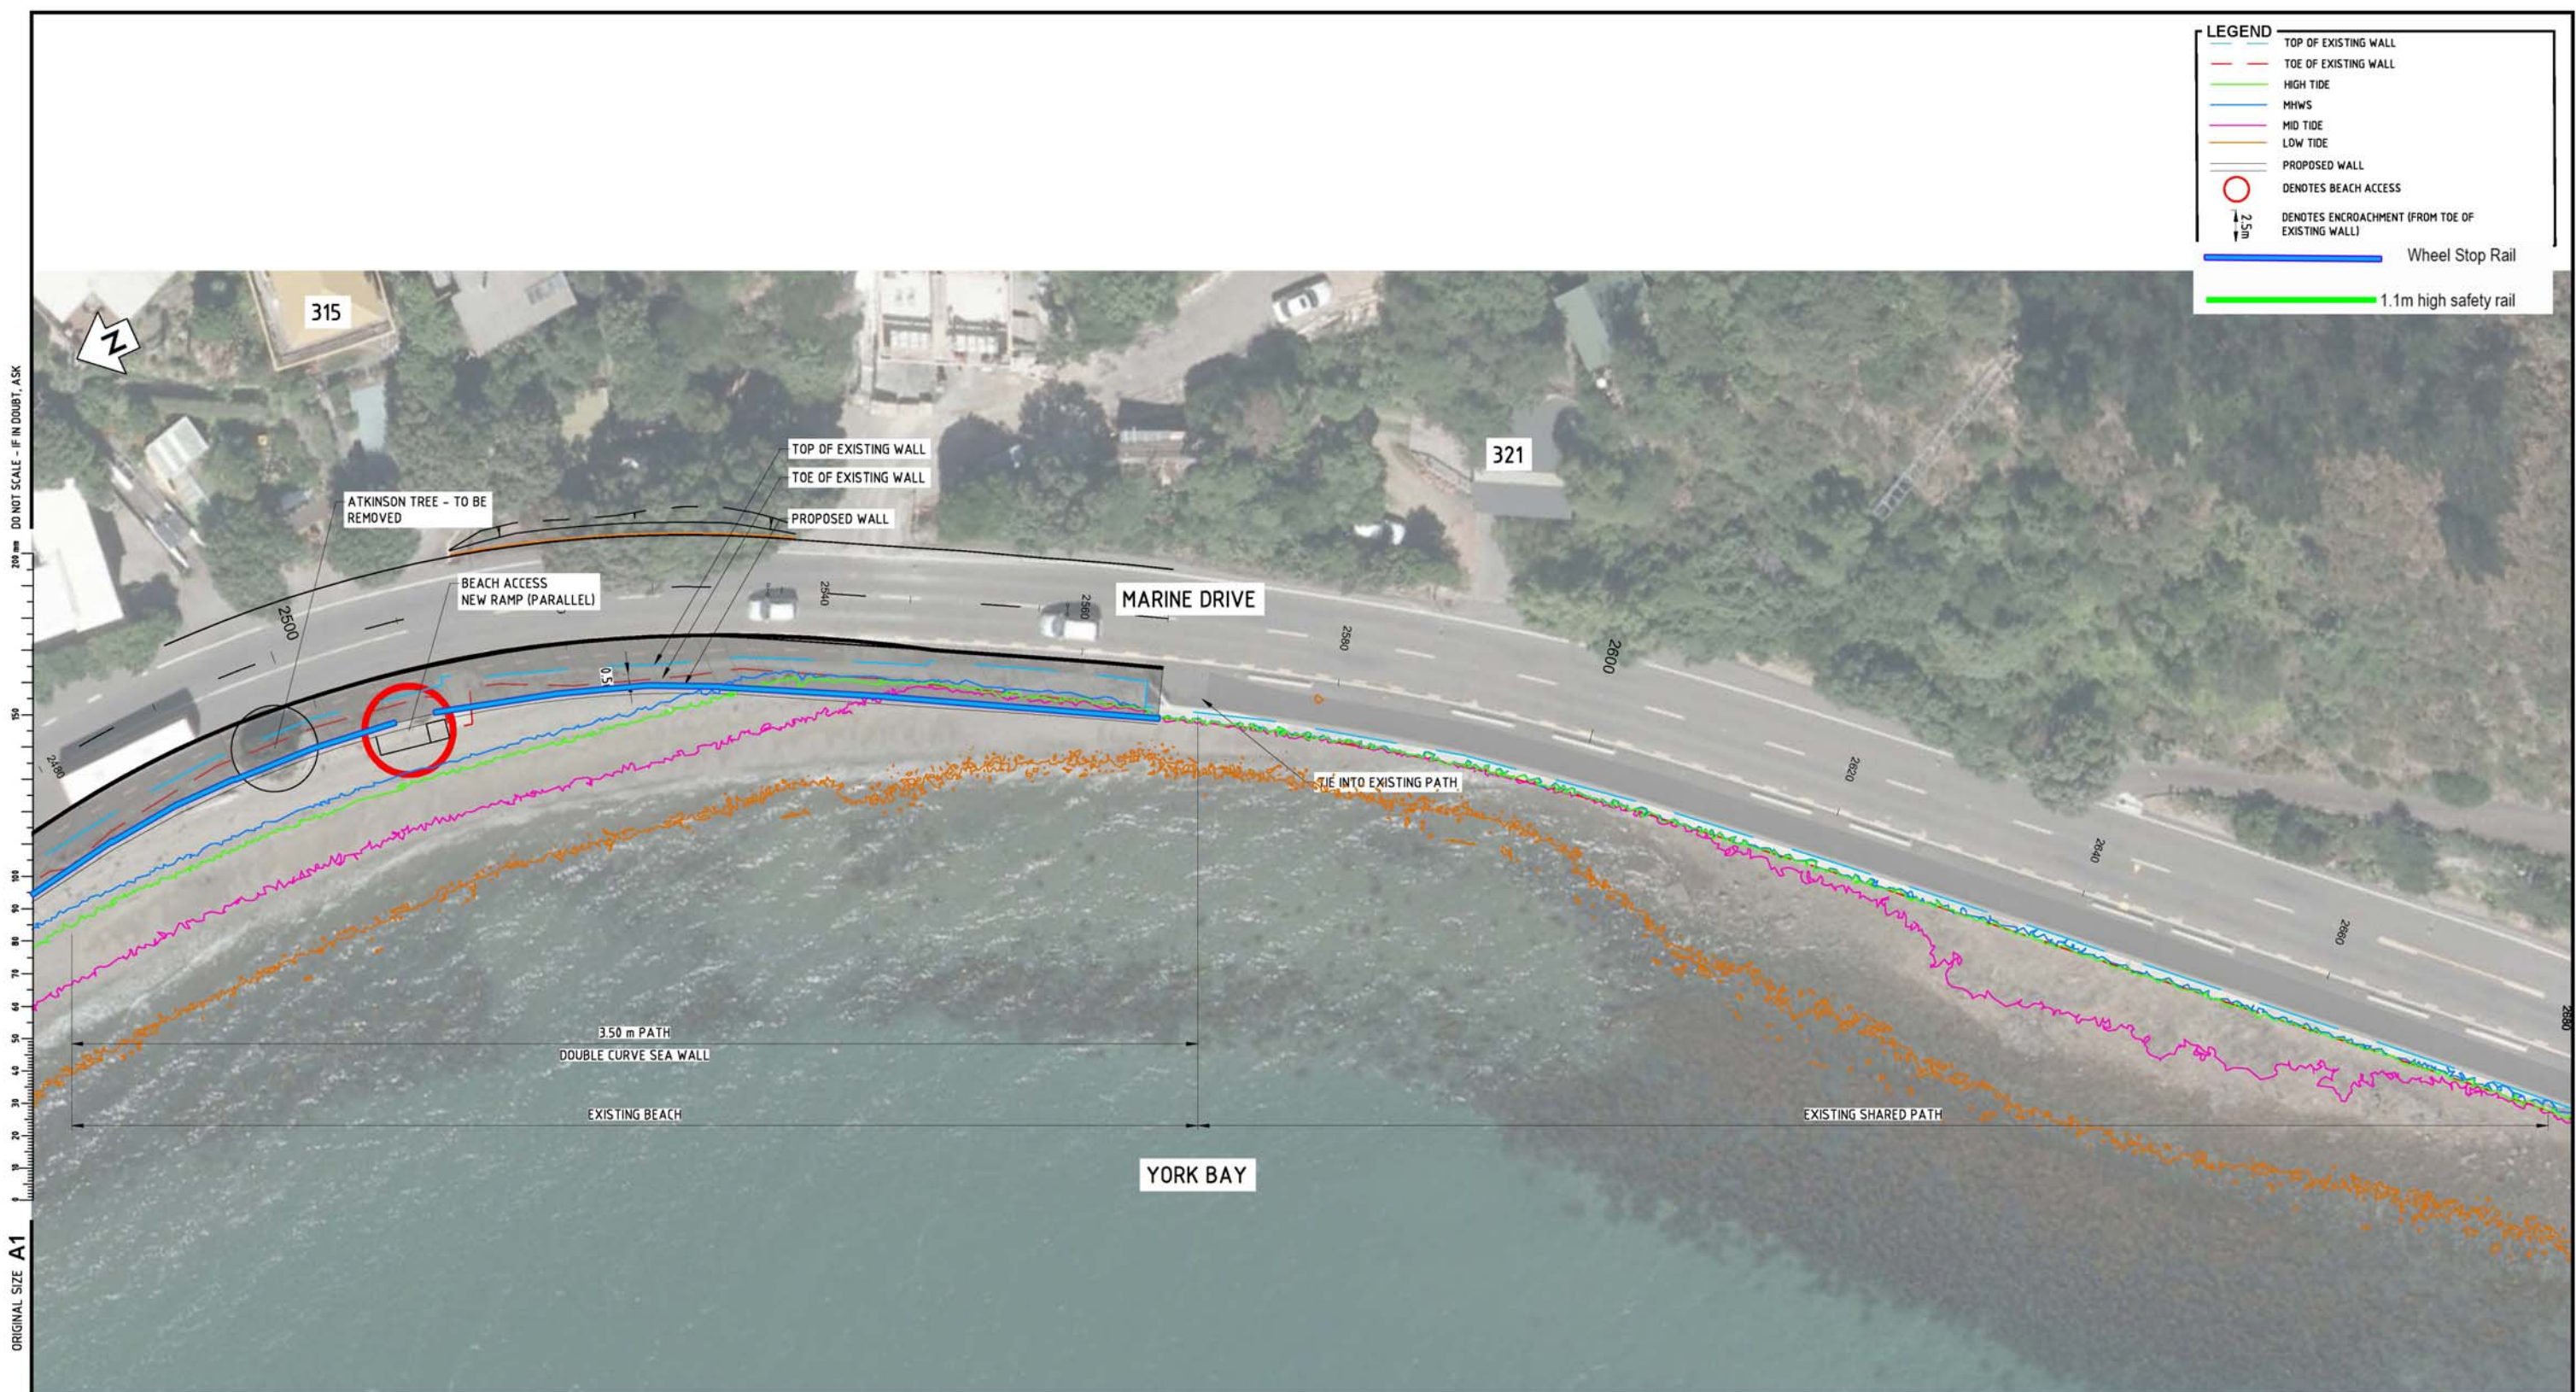

DO NOT SCALE - IF IN DOUBT, ASK

ORIGINAL SIZE A1

INDICATIVE - SUBJECT TO DETAILED DESIGN NOT FOR CONSTRUCTION

REV	DESCRIPTION	DRN	CHK	APP	DATE
J	FOR CONSENT - ROCK REVETMENT REMOVED AND PATH WIDTH CHANGED	KVS	JP		08/18
H	FOR CONSENT - MINOR AMENDMENT	KVS	JP		05/18
G	FOR CONSENT	KVS	JP		04/18
F	MINOR AMENDMENT	KVS	JP		09.03.2018
E	MINOR AMENDMENT	KVS	JP		02.03.2018
D	PRELIMINARY DESIGN	GC	JP		19.09.17
C	FOR REVIEW - MANY SHEETS ADDED, MANY SHEETS RE-NUMBERED	PJ COOK	JP		08/17
	REVISIONS	DRN	CHK	APP	DATE

SURVEYED	
DESIGNED	
DRAWN	
CAD REVIEW	
DESIGN CHECK	
DESIGN REVIEW	
APPROVED	NOT APPROVED
PROF REGISTRATION	

Client:


HUTT CITY COUNCIL
EASTERN BAYS SHARED PATH - DBC

PLAN - MCA0
YORK BAY STATION 2480 - 2680

Status Stamp	WORKING PLOT
Date Stamp	
Scales	1 : 250
Drawing No.	80509137-01-001-C231
Rev.	J

LEGEND	
	TOP OF EXISTING WALL
	TOE OF EXISTING WALL
	HIGH TIDE
	MHWS
	MID TIDE
	LOW TIDE
	PROPOSED WALL
	DENOTES BEACH ACCESS
	DENOTES ENCROACHMENT (FROM TOE OF EXISTING WALL)
	Wheel Stop Rail
	1.1m high safety rail

DO NOT SCALE - IF IN DOUBT, ASK

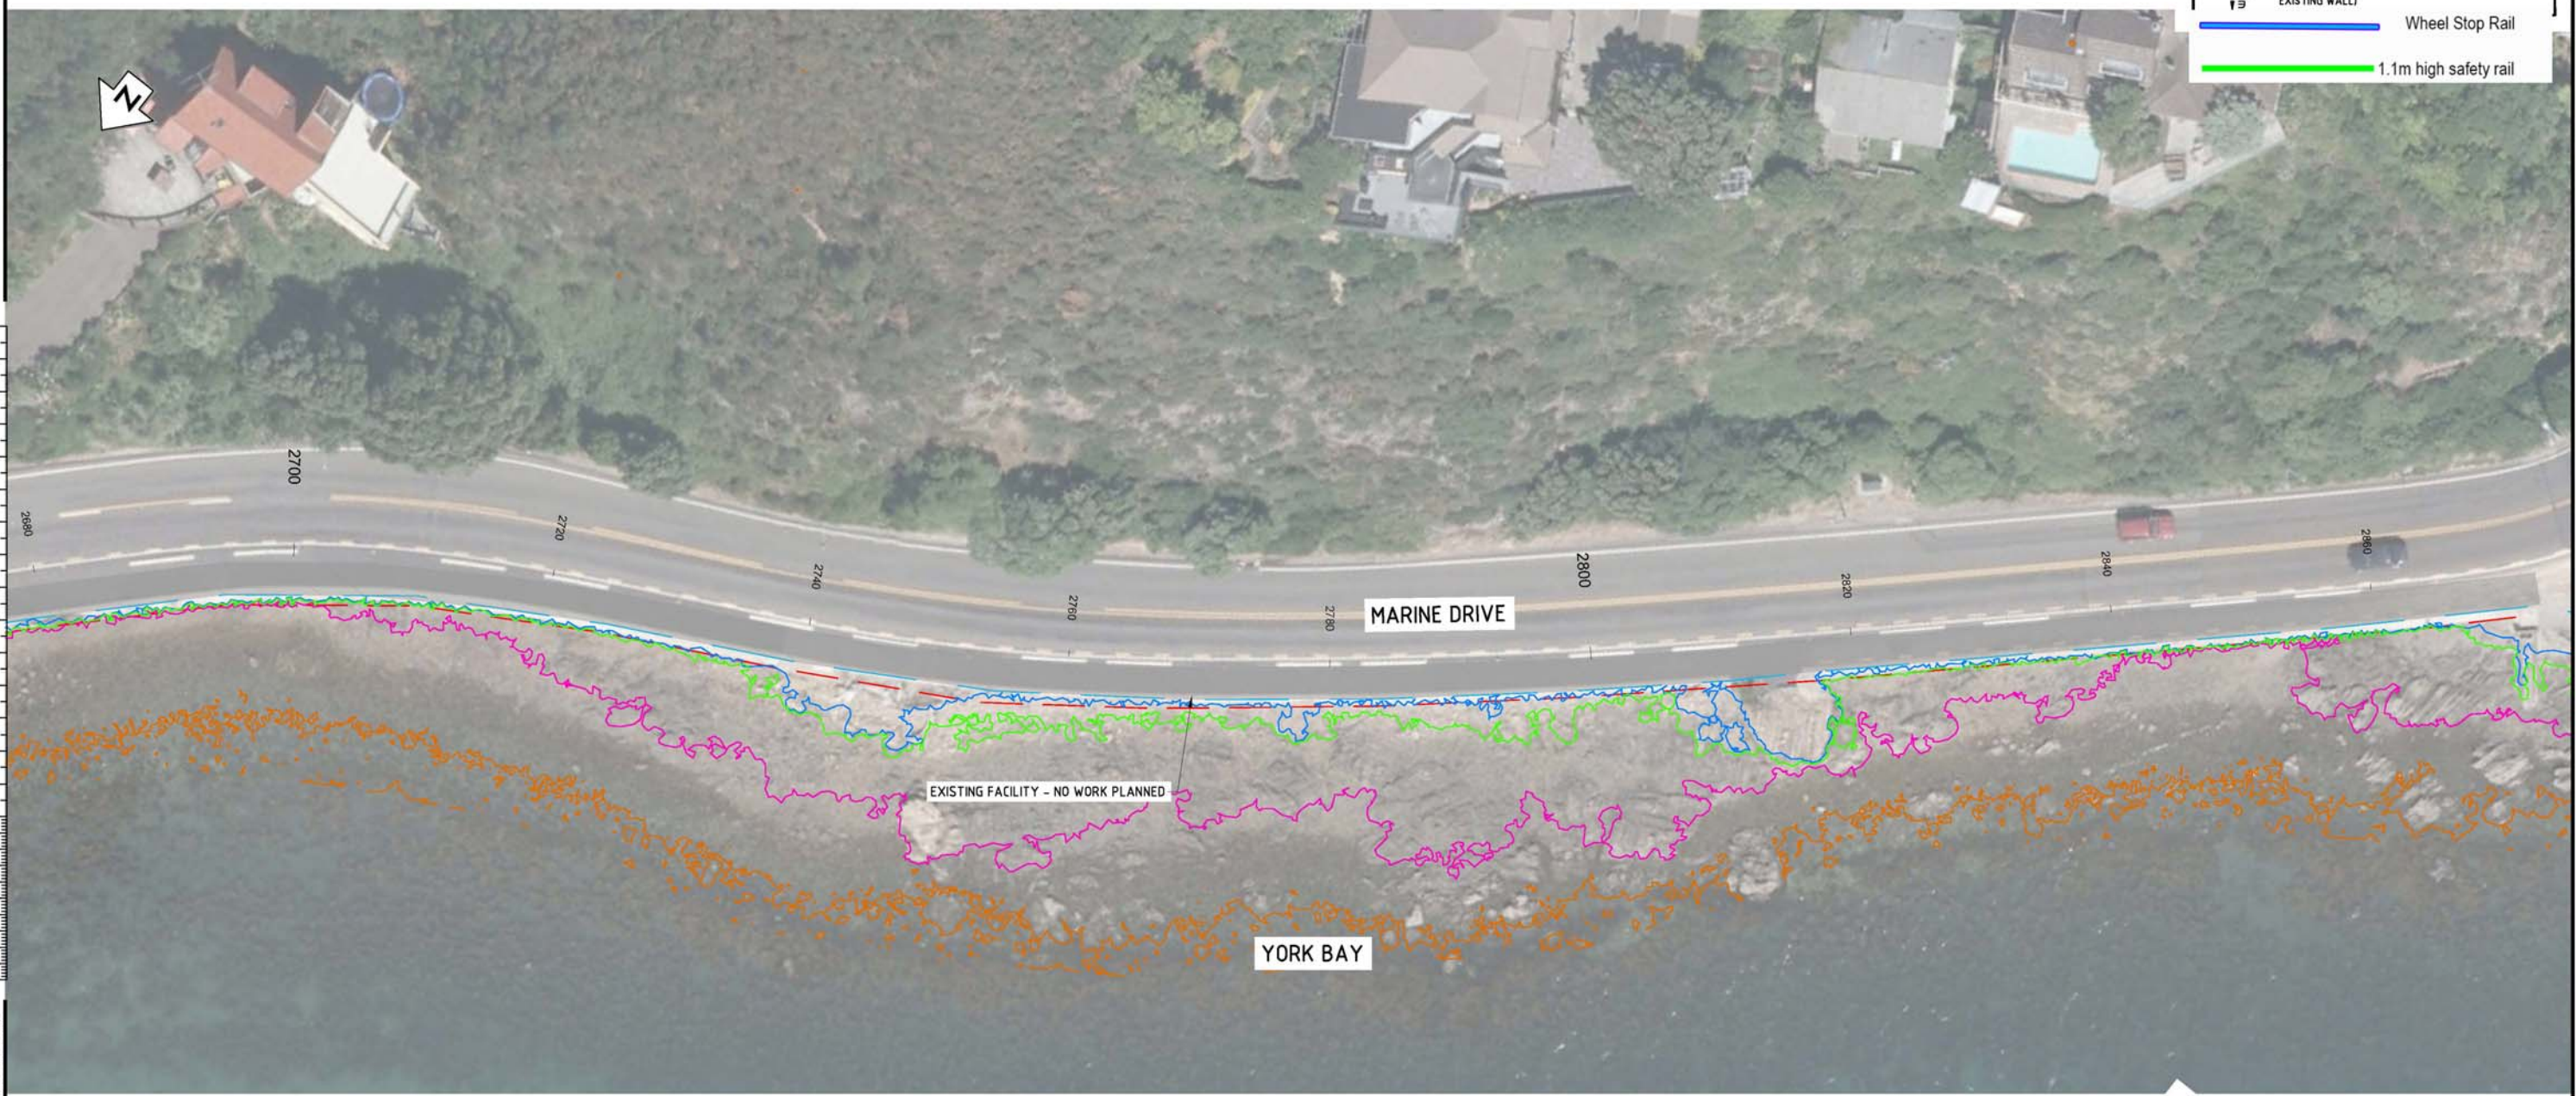

INDICATIVE - SUBJECT TO DETAILED DESIGN NOT FOR CONSTRUCTION

REV	DESCRIPTION	DRN	CHK	APP	DATE
J	FOR CONSENT - ROCK REVETMENT REMOVED AND PATH WIDTH CHANGED	KVS	JP		08/18
H	FOR CONSENT - MINOR AMENDMENT	KVS	JP		05/18
G	FOR CONSENT	KVS	JP		04/18
F	MINOR AMENDMENT	KVS	JP		09.03.2018
E	MINOR AMENDMENT	KVS	JP		02.03.2018
D	PRELIMINARY DESIGN	GC	JP		19.09.17
C	FOR REVIEW - MANY SHEETS ADDED, MANY SHEETS RE-NUMBERED	PJ COOK	JP		08/17
	REVISIONS	DRN	CHK	APP	DATE

SURVEYED	DESIGNED	DRAWN	CAD REVIEW	DESIGN CHECK	DESIGN REVIEW	APPROVED	PROF REGISTRATION
						NOT APPROVED	


Client:

HUTT CITY
TE AWA KAIRANGI

HUTT CITY COUNCIL
EASTERN BAYS SHARED PATH - DBC

PLAN - MCA0
YORK BAY TO MAHINA BAY STATION 2680 - 2873

Status Stamp	WORKING PLOT	
Date Stamp		
Scales	AS SHOWN	
Drawing No.	80509137-01-001-C232	Rev. J

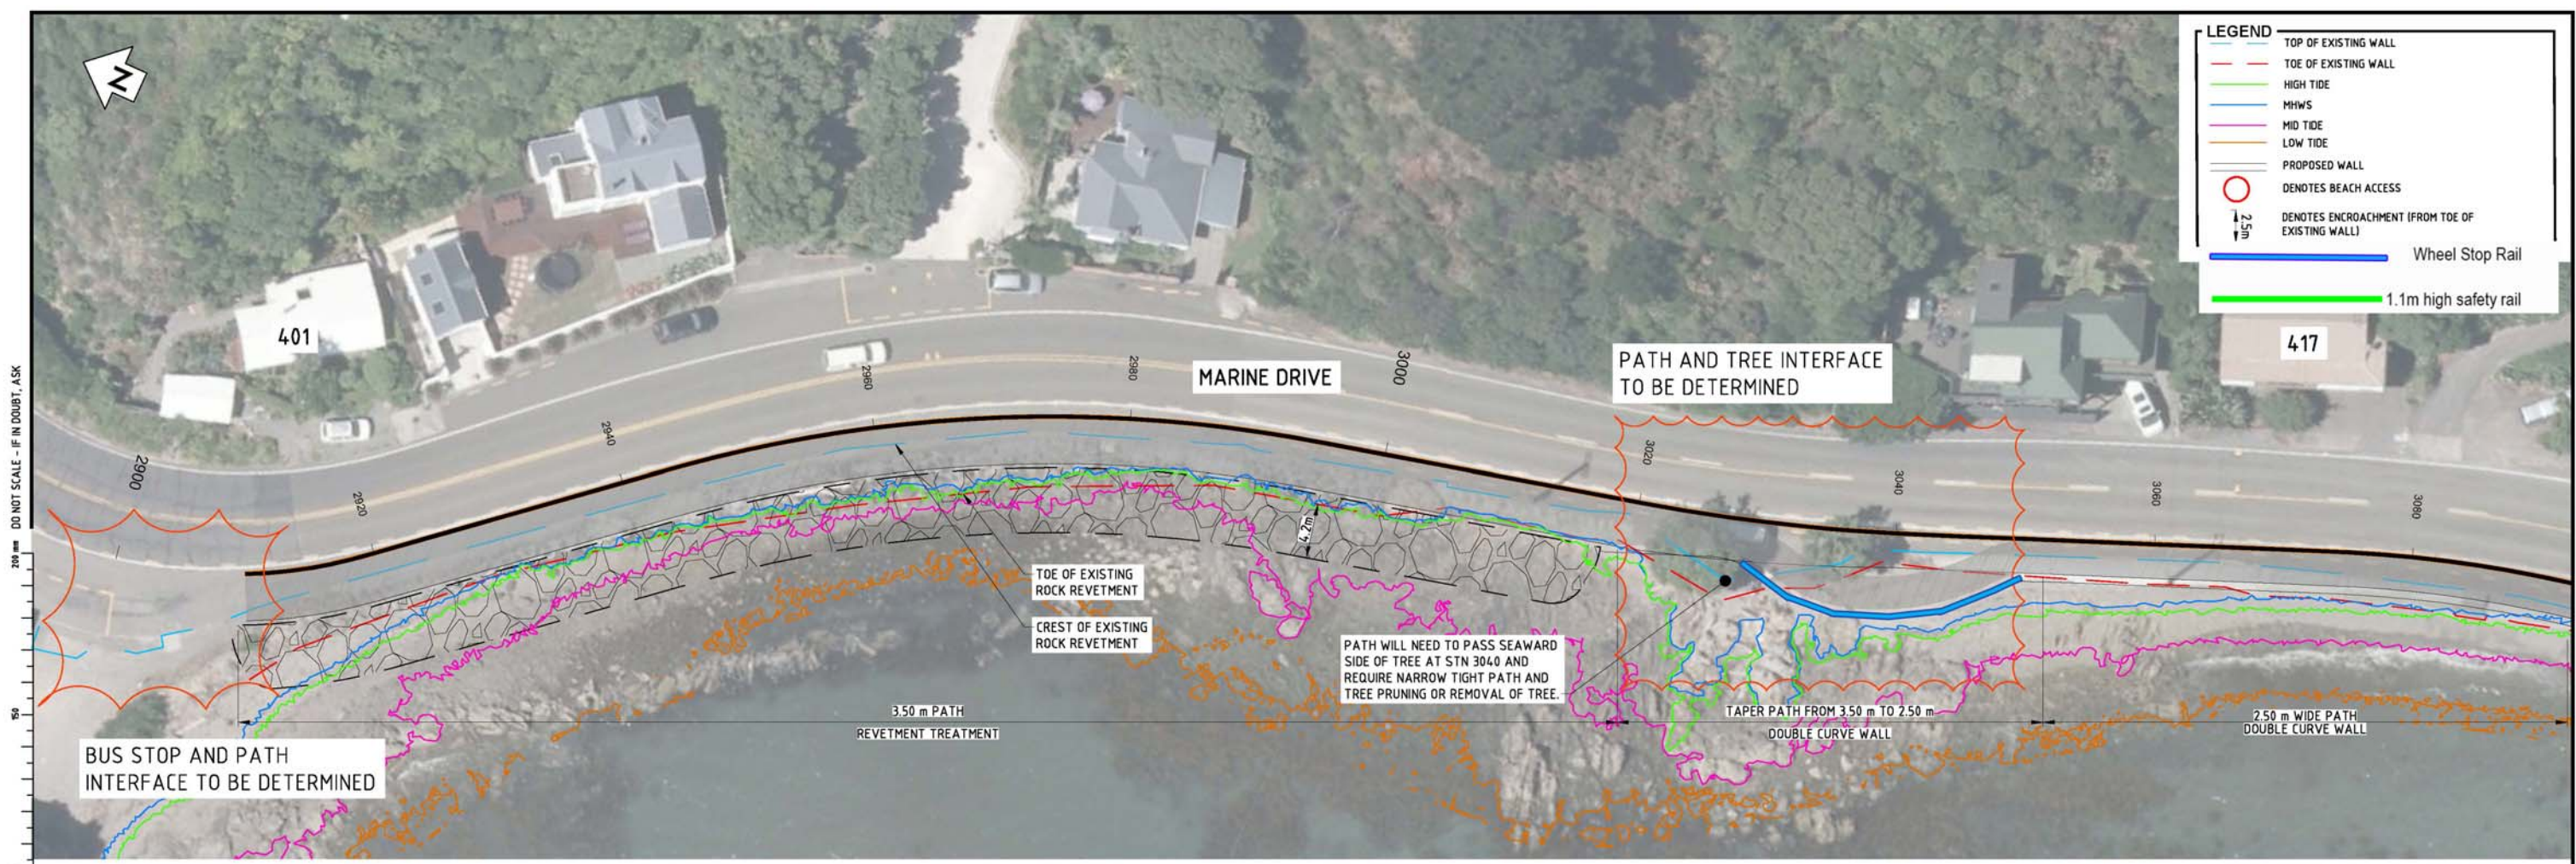

PLAN
SCALE 1 : 250

DO NOT SCALE - IF IN DOUBT, ASK

ORIGINAL SIZE A1


Last modified: Aug 24, 2018 By Kevin Singh

INDICATIVE - SUBJECT TO DETAILED DESIGN NOT FOR CONSTRUCTION

REV	DESCRIPTION	DRN	CHK	APP	DATE	SURVEYED	DESIGNED	DRAWN	CAD REVIEW	DESIGN CHECK	DESIGN REVIEW	APPROVED	PROF REGISTRATION
J	FOR CONSENT - ROCK REVETMENT REMOVED AND PATH WIDTH CHANGED	KVS	JP		08/18								
H	FOR CONSENT - MINOR AMENDMENT	KVS	JP		05/18								
G	FOR CONSENT	KVS	JP		04/18								
F	MINOR AMENDMENT	KVS	JP		09.03.2018								
E	MINOR AMENDMENT	KVS	JP		02.03.2018								
D	PRELIMINARY DESIGN	GC	JP		19.09.17								
C	FOR REVIEW - MANY SHEETS ADDED, MANY SHEETS RE-NUMBERED	PJ COOK	JP		08/17								
REV		DRN	CHK	APP	DATE								

NOT APPROVED


		Client:	HUTT CITY COUNCIL EASTERN BAYS SHARED PATH - DBC	Status Stamp	WORKING PLOT
		PLAN - MCA0 MAHINA BAY STATION 2900 - 3080	Drawing No.	80509137-01-001-C233	Rev.

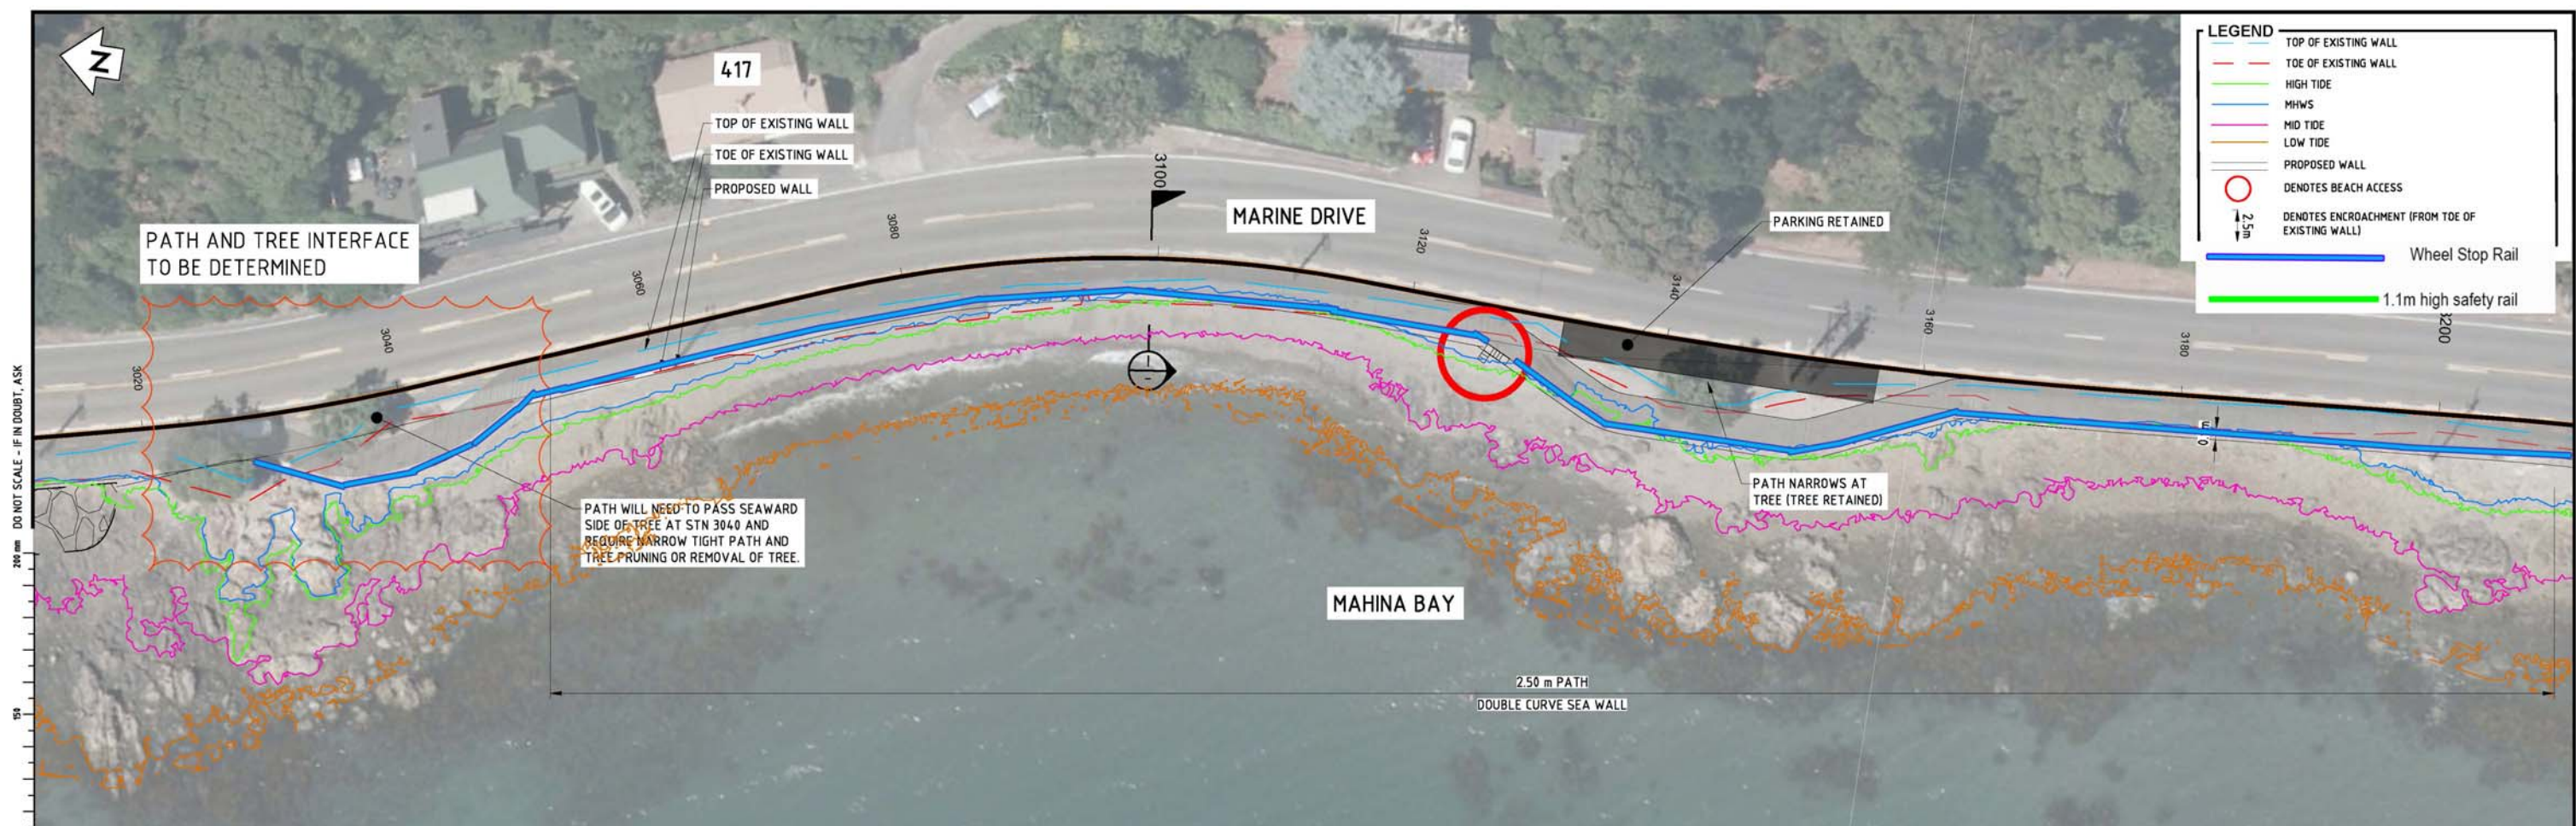

DO NOT SCALE - IF IN DOUBT, ASK

ORIGINAL SIZE A1

Last modified: Nov 23 2018 By Kevin Singh

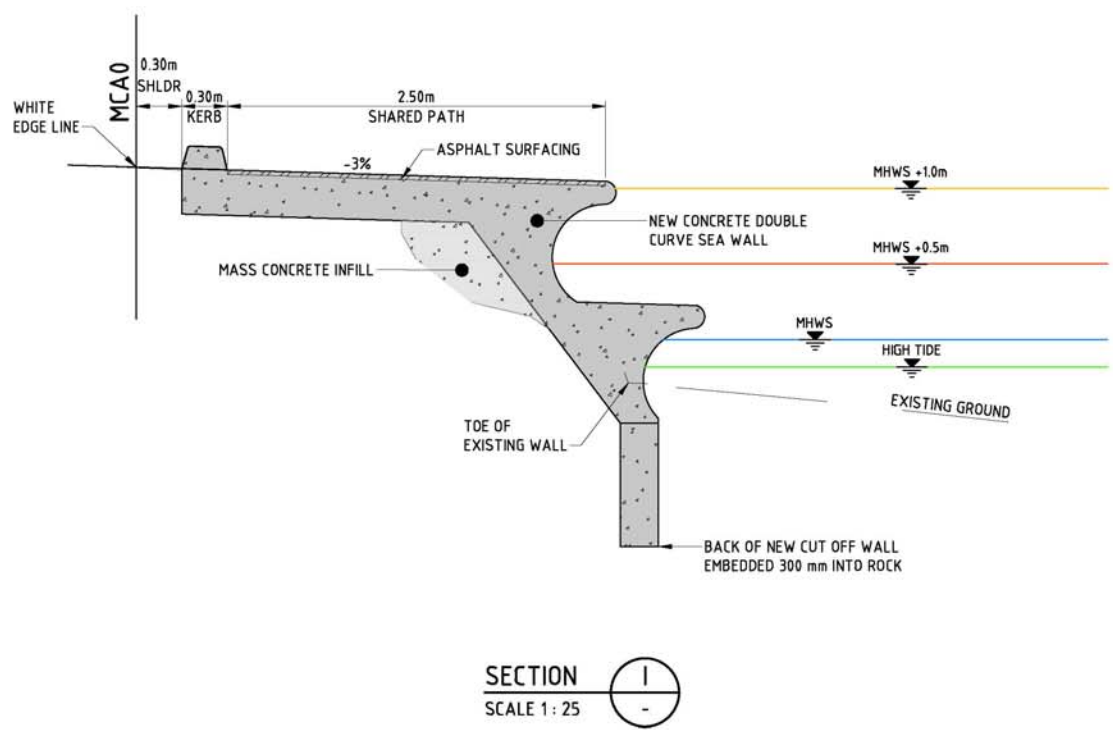

SECTION I-1
SCALE 1:25

INDICATIVE - SUBJECT TO DETAILED DESIGN NOT FOR CONSTRUCTION

REV	DESCRIPTION	DRN	CHK	APP	DATE
J	FOR CONSENT - ROCK REVETMENT REMOVED AND PATH WIDTH CHANGED	KVS	JP		08/18
H	FOR CONSENT - MINOR AMENDMENT	KVS	JP		05/18
G	FOR CONSENT	KVS	JP		04/18
F	MINOR AMENDMENT	KVS	JP		09.03.2018
E	MINOR AMENDMENT	KVS	JP		02.03.2018
D	PRELIMINARY DESIGN	GC	JP		19.09.17
C	FOR REVIEW - MANY SHEETS ADDED, MANY SHEETS RE-NUMBERED	PJ COOK	JP		08/17
	REVISIONS				

SURVEYED	DESIGNED	DRAWN	CAD REVIEW	DESIGN CHECK	DESIGN REVIEW	APPROVED	PROF REGISTRATION:




HUTT CITY COUNCIL
EASTERN BAYS SHARED PATH - DBC

PLAN - MCAO
MAHINA BAY STATION 3020 - 3200

Status Stamp	WORKING PLOT
Date Stamp	
Scales	1:250 (A1)
Drawing No.	80509137-01-001-C234
Rev.	J

LEGEND

- TOP OF EXISTING WALL
- TOE OF EXISTING WALL
- HIGH TIDE
- MHWS
- MID TIDE
- LOW TIDE
- PROPOSED WALL
- DENOTES BEACH ACCESS
- DENOTES ENCROACHMENT (FROM TOE OF EXISTING WALL)
- Wheel Stop Rail
- 1.1m high safety rail

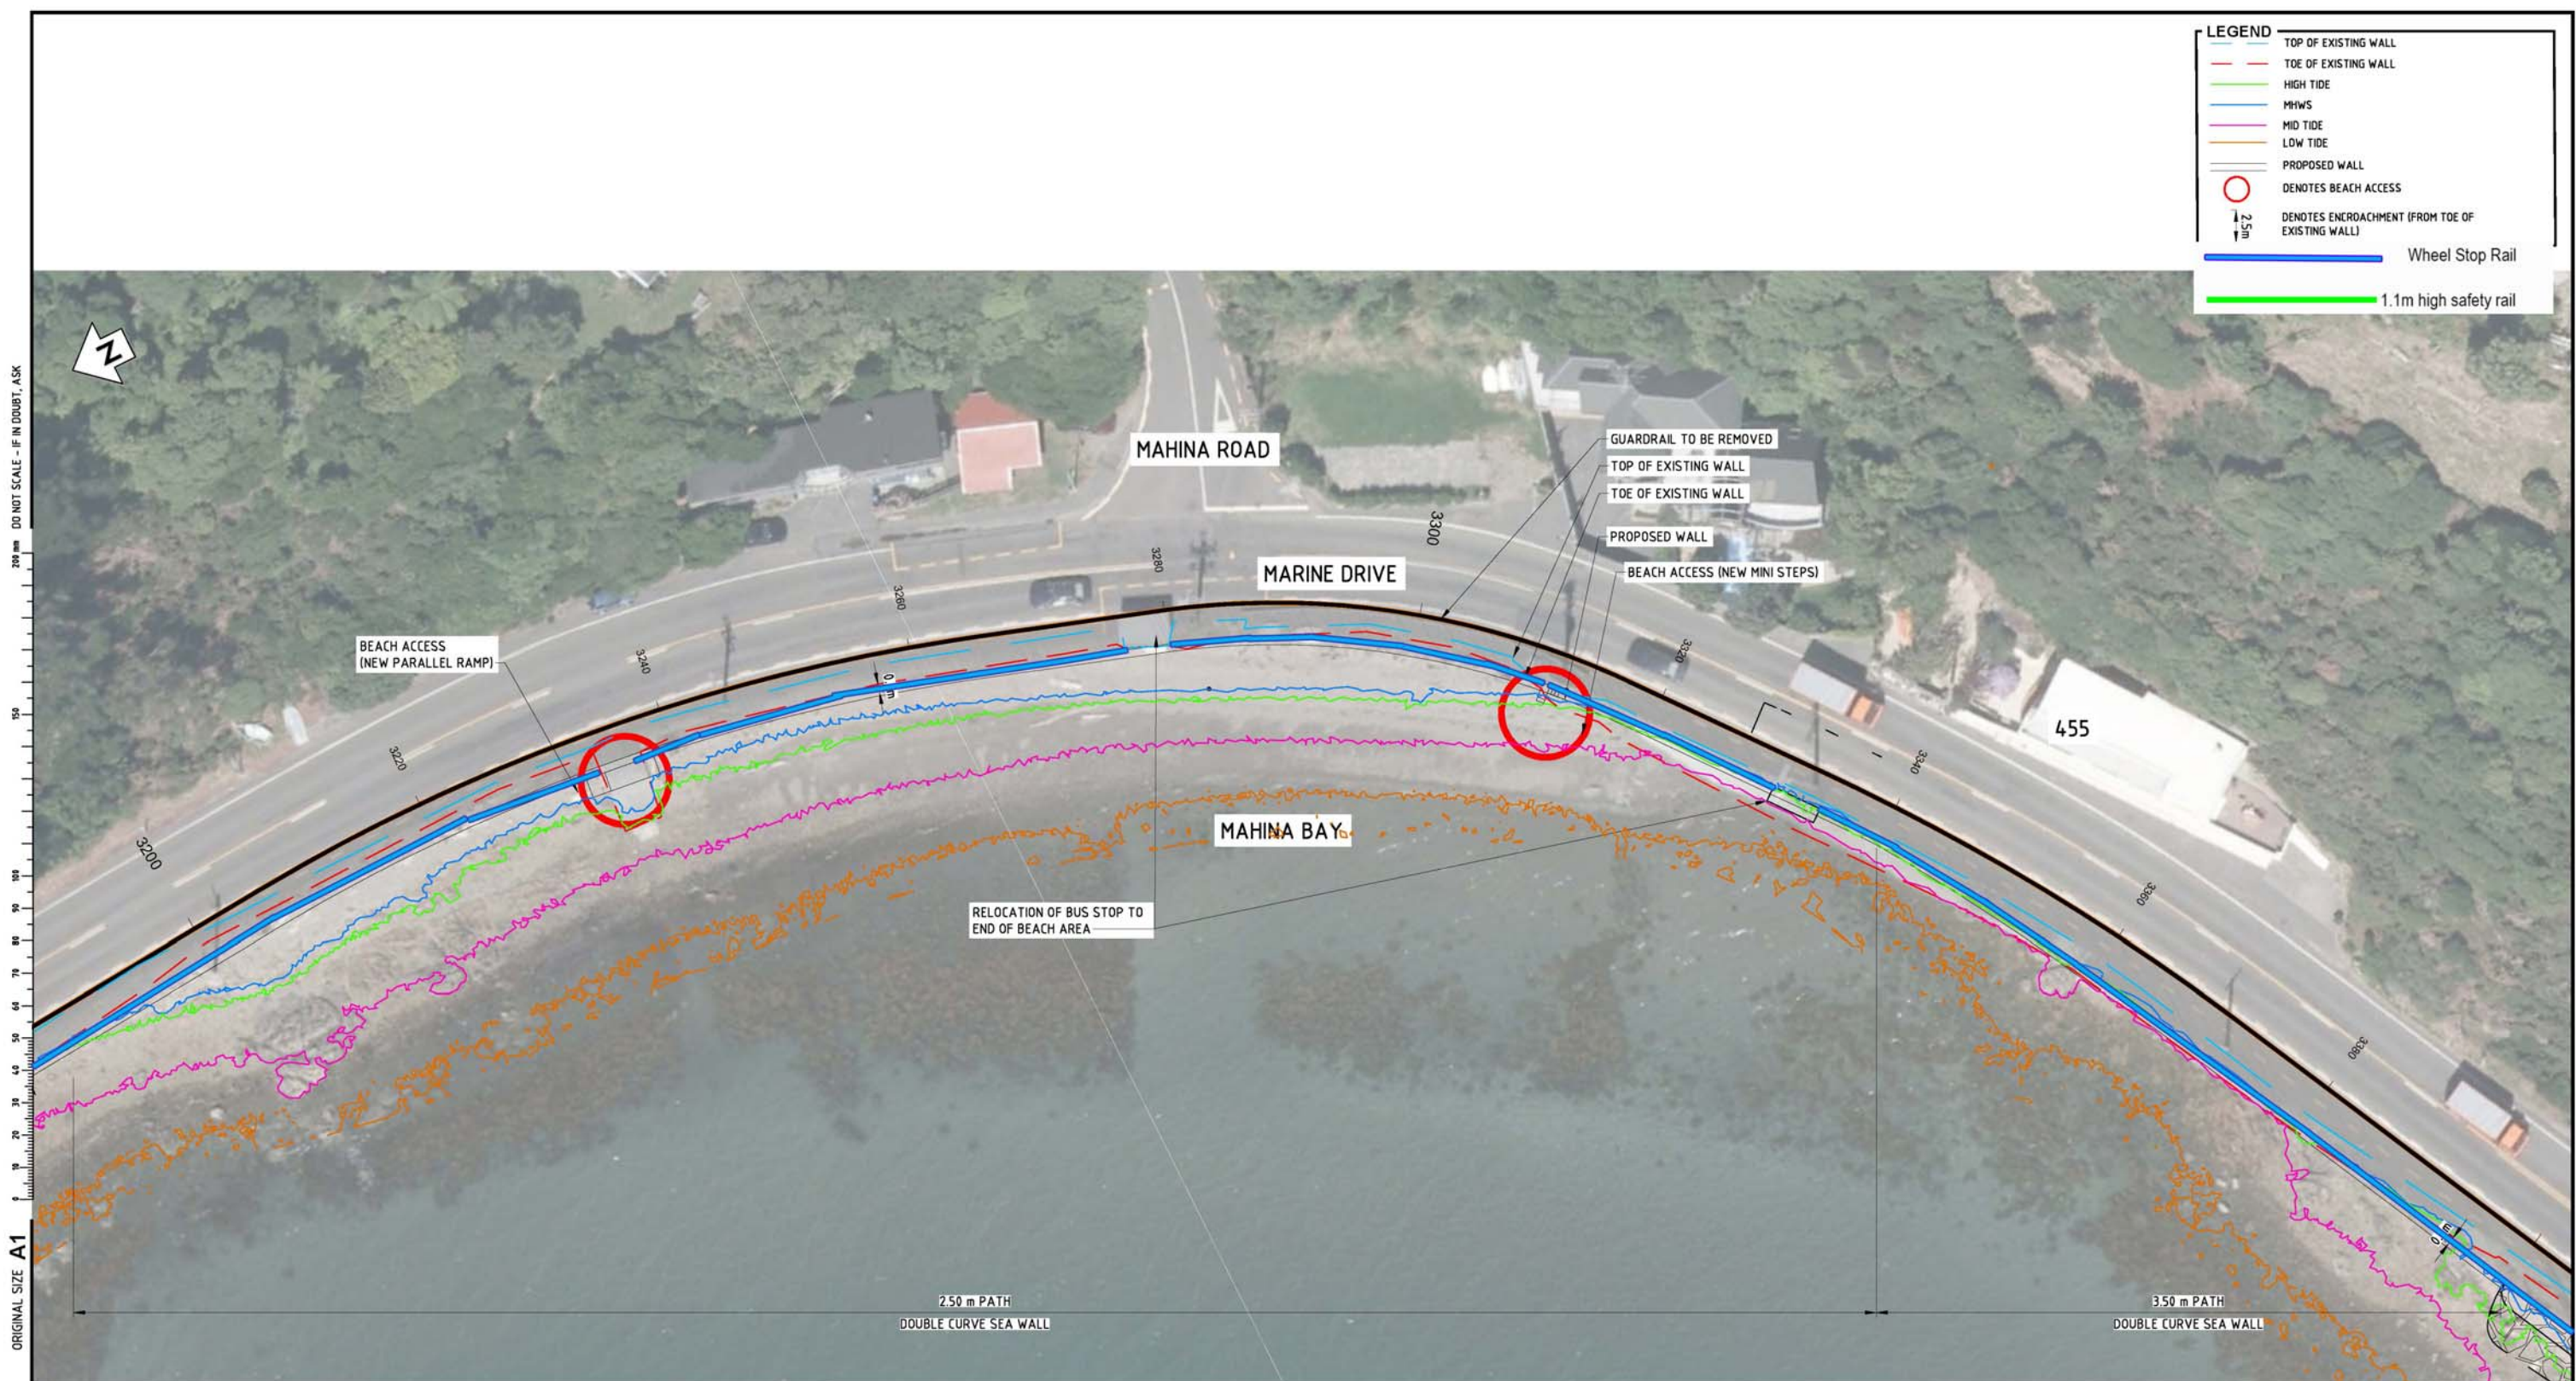


INDICATIVE - SUBJECT TO DETAILED DESIGN NOT FOR CONSTRUCTION

REV	DESCRIPTION	DRN	CHK	APP	DATE
J	FOR CONSENT - ROCK REVETMENT REMOVED AND PATH WIDTH CHANGED	KVS	JP		08/18
H	FOR CONSENT - MINOR AMENDMENT	KVS	JP		05/18
G	FOR CONSENT	KVS	JP		04/18
F	MINOR AMENDMENT	KVS	JP		09.03.2018
E	MINOR AMENDMENT	KVS	JP		02.03.2018
D	PRELIMINARY DESIGN	GC	JP		19.09.17
C	FOR REVIEW - MANY SHEETS ADDED, MANY SHEETS RE-NUMBERED	PJ COOK	JP		08/17
	REVISIONS				

SURVEYED	DESIGNED	DRAWN	CAD REVIEW	DESIGN CHECK	DESIGN REVIEW	APPROVED	PROF REGISTRATION
						NOT APPROVED	

Client:


HUTT CITY COUNCIL
EASTERN BAYS SHARED PATH - DBC

PLAN - MCA0
MAHINA BAY STATION 3200 - 3380

Status Stamp	WORKING PLOT	
Date Stamp		
Scales	1 : 250 (A1)	
Drawing No.	80509137-01-001-C235	Rev. J

Last modified: Aug 24, 2018 By Kevin Singh

LEGEND	
	TOP OF EXISTING WALL
	TOE OF EXISTING WALL
	HIGH TIDE
	MHWS
	MID TIDE
	LOW TIDE
	PROPOSED WALL
	DENOTES BEACH ACCESS
	DENOTES ENCROACHMENT (FROM TOE OF EXISTING WALL)
	Wheel Stop Rail
	1.1m high safety rail

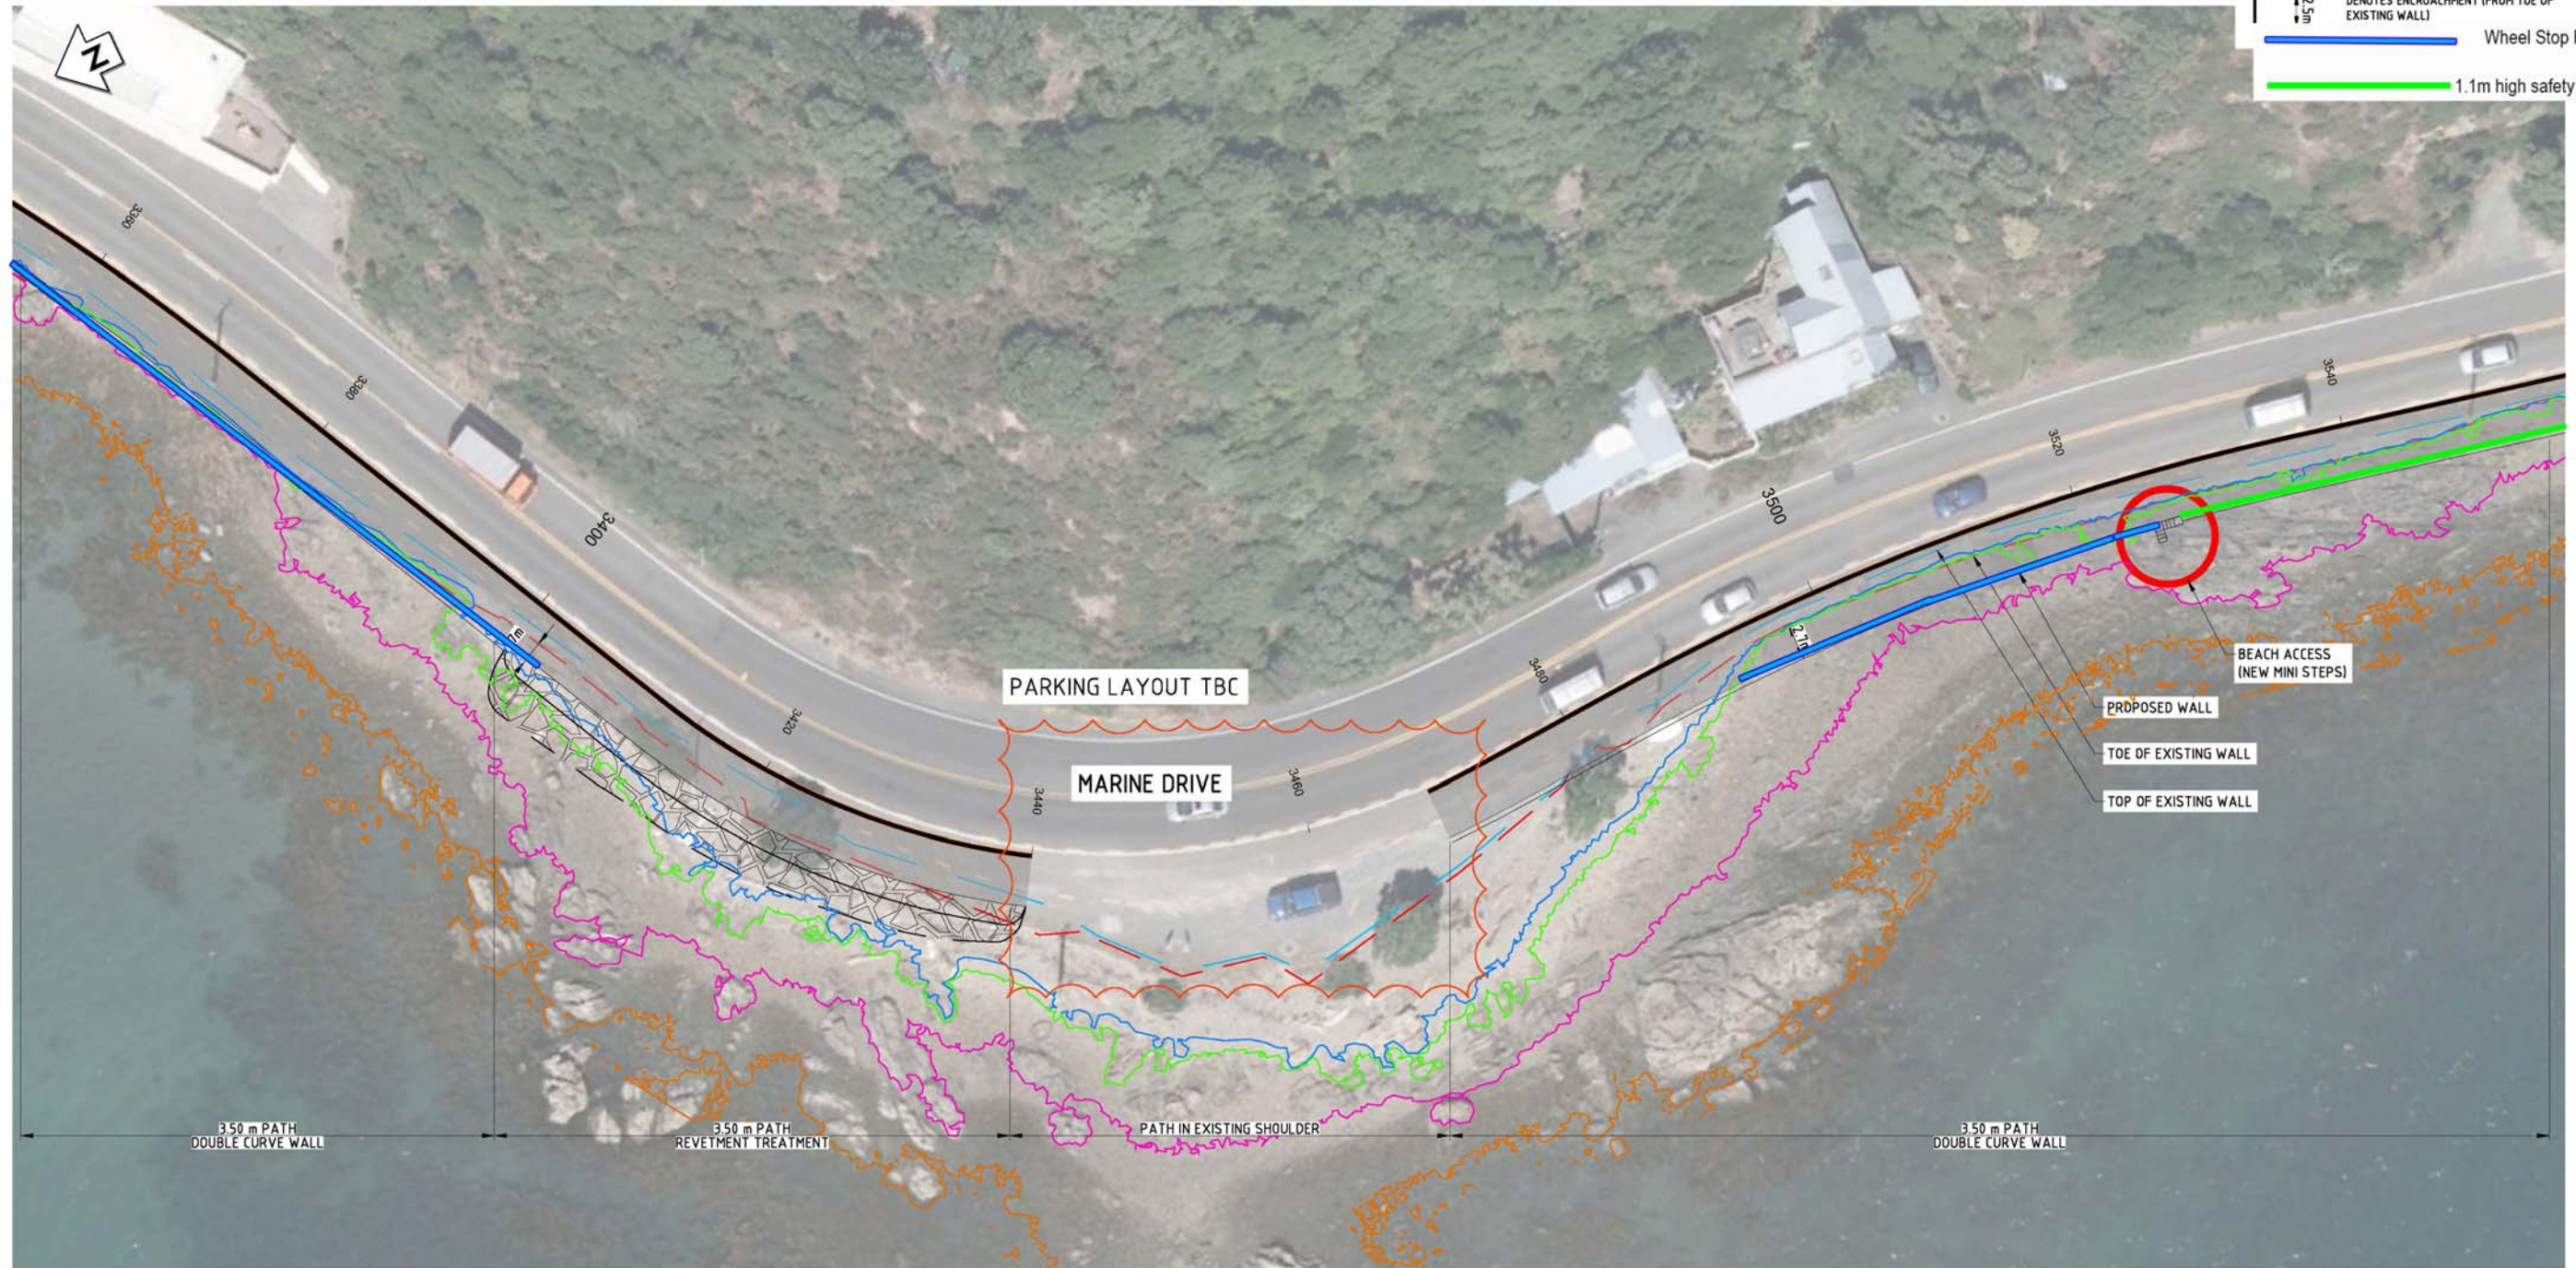

INDICATIVE - SUBJECT TO DETAILED DESIGN NOT FOR CONSTRUCTION

REV	DESCRIPTION	DRN	CHK	APP	DATE
J	FOR CONSENT - ROCK REVETMENT REMOVED AND PATH WIDTH CHANGED	KVS	JP		08/18
H	FOR CONSENT - MINOR AMENDMENT	KVS	JP		05/18
G	FOR CONSENT	KVS	JP		04/18
F	MINOR AMENDMENT	KVS	JP		09.03.2018
E	MINOR AMENDMENT	KVS	JP		02.03.2018
D	PRELIMINARY DESIGN	GC	JP		19.09.17
C	FOR REVIEW - MANY SHEETS ADDED, MANY SHEETS RE-NUMBERED	PJ COOK	JP		08/17
	REVISIONS				

SURVEYED	DESIGNED	DRAWN	CAD REVIEW	DESIGN CHECK	DESIGN REVIEW	APPROVED	PROF REGISTRATION
						NOT APPROVED	

Client: **Stantec** **HUTT CITY**
TE AWA KAIRANGI

HUTT CITY COUNCIL
EASTERN BAYS SHARED PATH - DBC
PLAN - MCA0
MAHINA BAY TO SUNSHINE BAY STATION 3360 - 3540

Status Stamp	WORKING PLOT
Date Stamp	
Scales	AS SHOWN
Drawing No.	80509137-01-001-C236
Rev.	J

Last modified: Aug 24, 2018 By Kevin Singh

DO NOT SCALE - IF IN DOUBT, ASK

200 mm
50
100
90
80
70
60
50
40
30
20
10

ORIGINAL SIZE A1

Last modified: Aug 24, 2018 By Kevin Singh

LEGEND

- TOP OF EXISTING WALL
- TOE OF EXISTING WALL
- HIGH TIDE
- MHWS
- MID TIDE
- LOW TIDE
- PROPOSED WALL
- DENOTES BEACH ACCESS
- ↑ DENOTES ENCROACHMENT (FROM TOE OF EXISTING WALL)
- Wheel Stop Rail
- 1.1m high safety rail





INDICATIVE - SUBJECT TO DETAILED DESIGN NOT FOR CONSTRUCTION

REV	DESCRIPTION	DRN	CHK	APP	DATE
J	FOR CONSENT - ROCK REVETMENT REMOVED AND PATH WIDTH CHANGED	KVS	JP		08/18
H	FOR CONSENT - MINOR AMENDMENT	KVS	JP		05/18
G	FOR CONSENT	KVS	JP		04/18
F	MINOR AMENDMENT	KVS	JP		09.03.2018
E	MINOR AMENDMENT	KVS	JP		02.03.2018
D	PRELIMINARY DESIGN	GC	JP		19.09.17
C	FOR REVIEW - MANY SHEETS ADDED, MANY SHEETS RE-NUMBERED	PJ COOK	JP		08/17
	REVISIONS				

SURVEYED	DESIGNED	DRAWN	CAD REVIEW	DESIGN CHECK	DESIGN REVIEW	APPROVED	PROF REGISTRATION
						NOT APPROVED	


Client:


HUTT CITY COUNCIL
EASTERN BAYS SHARED PATH - DBC

PLAN - MCA0
MAHINA BAY TO SUNSHINE BAY STATION 3540 - 3680

Status Stamp	WORKING PLOT
Date Stamp	
Scales	AS SHOWN
Drawing No.	80509137-01-001-C237
Rev.	J

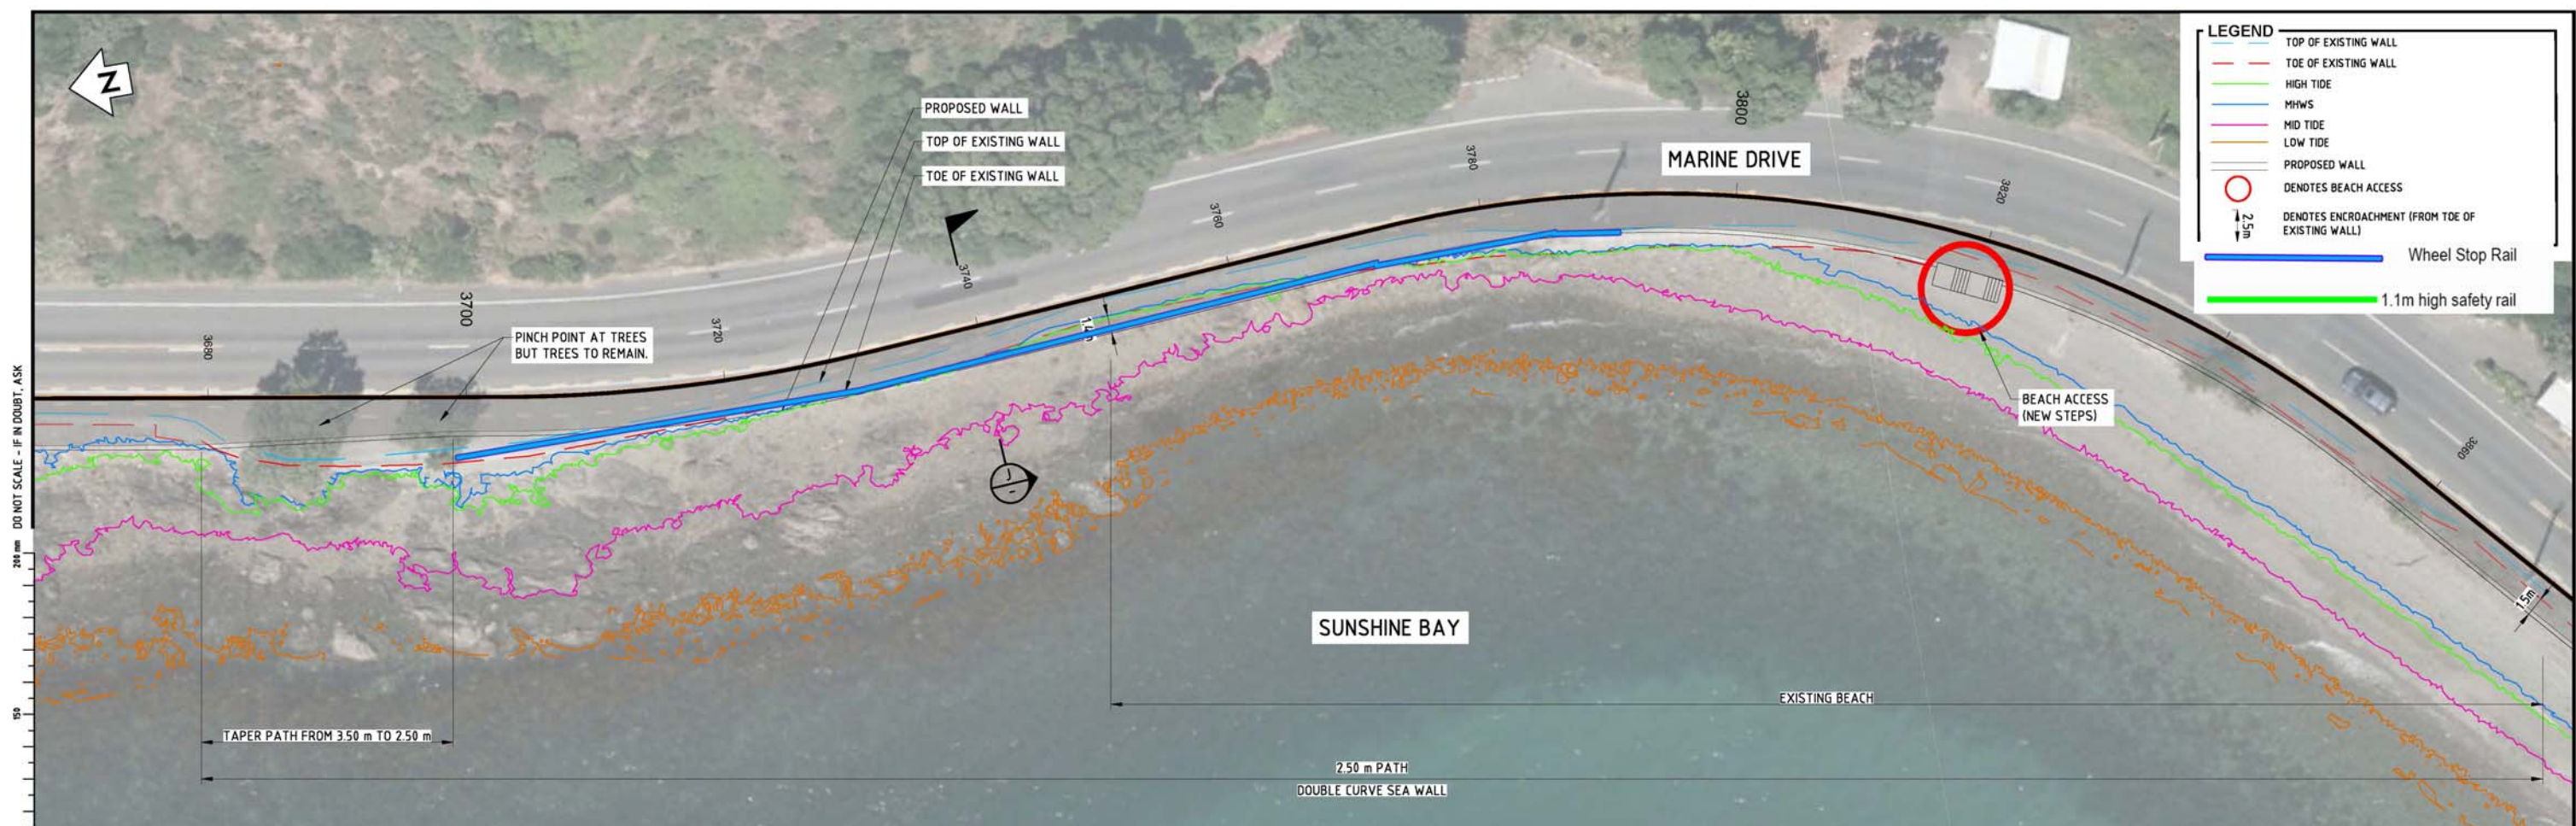

LEGEND	
	TOP OF EXISTING WALL
	TOE OF EXISTING WALL
	HIGH TIDE
	MHWS
	MID TIDE
	LOW TIDE
	PROPOSED WALL
	DENOTES BEACH ACCESS
	DENOTES ENCROACHMENT (FROM TOE OF EXISTING WALL)
	Wheel Stop Rail
	1.1m high safety rail

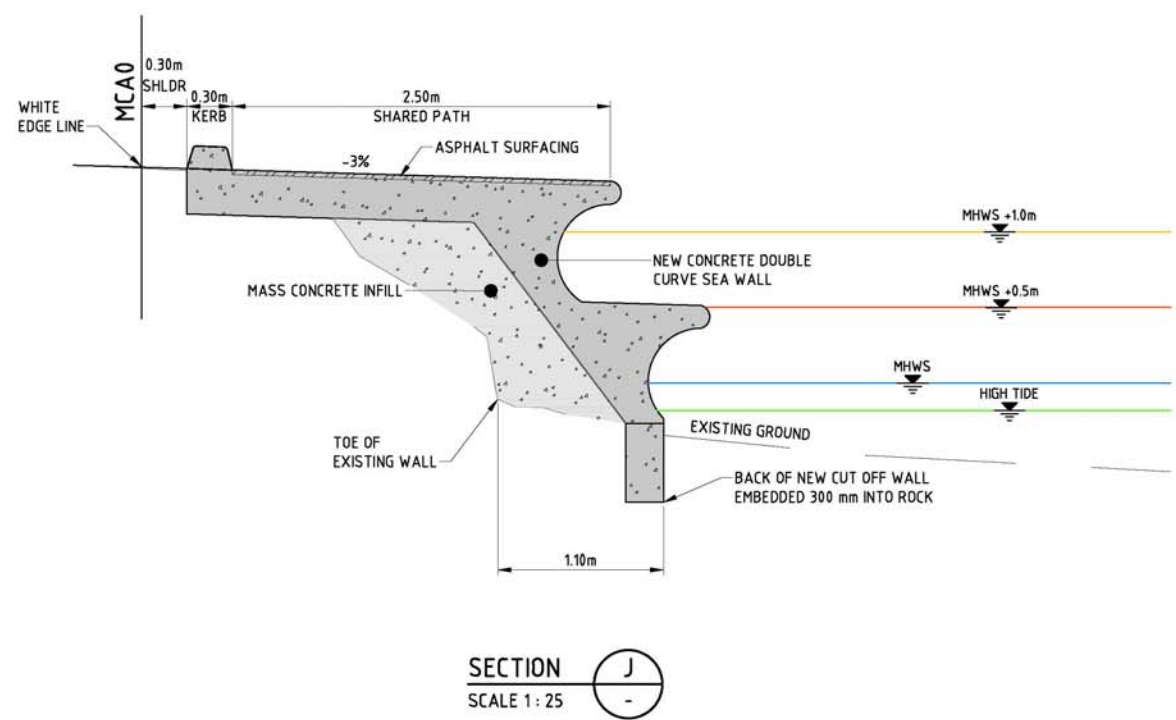

INDICATIVE - SUBJECT TO DETAILED DESIGN NOT FOR CONSTRUCTION

REV	DESCRIPTION	DRN	CHK	APP	DATE
J	FOR CONSENT - ROCK REVETMENT REMOVED AND PATH WIDTH CHANGED	KVS	JP		08/18
H	FOR CONSENT - MINOR AMENDMENT	KVS	JP		05/18
G	FOR CONSENT	KVS	JP		04/18
F	MINOR AMENDMENT	KVS	JP		09.03.2018
E	MINOR AMENDMENT	KVS	JP		02.03.2018
D	PRELIMINARY DESIGN	GC	JP		19.09.17
C	FOR REVIEW - MANY SHEETS ADDED, MANY SHEETS RE-NUMBERED	PJ COOK	JP		08/17
REV	REVISIONS	DRN	CHK	APP	DATE


SURVEYED	
DESIGNED	
DRAWN	
CAD REVIEW	
DESIGN CHECK	
DESIGN REVIEW	
APPROVED	NOT APPROVED
PROF REGISTRATION:	

Client:

HUTT CITY COUNCIL
EASTERN BAYS SHARED PATH - DBC

PLAN - MCA0
SUNSHINE BAY STATION 3680 - 3860

Status Stamp	WORKING PLOT
Date Stamp	
Scales	1 : 250 (A1)
Drawing No.	80509137-01-001-C238
Rev.	J

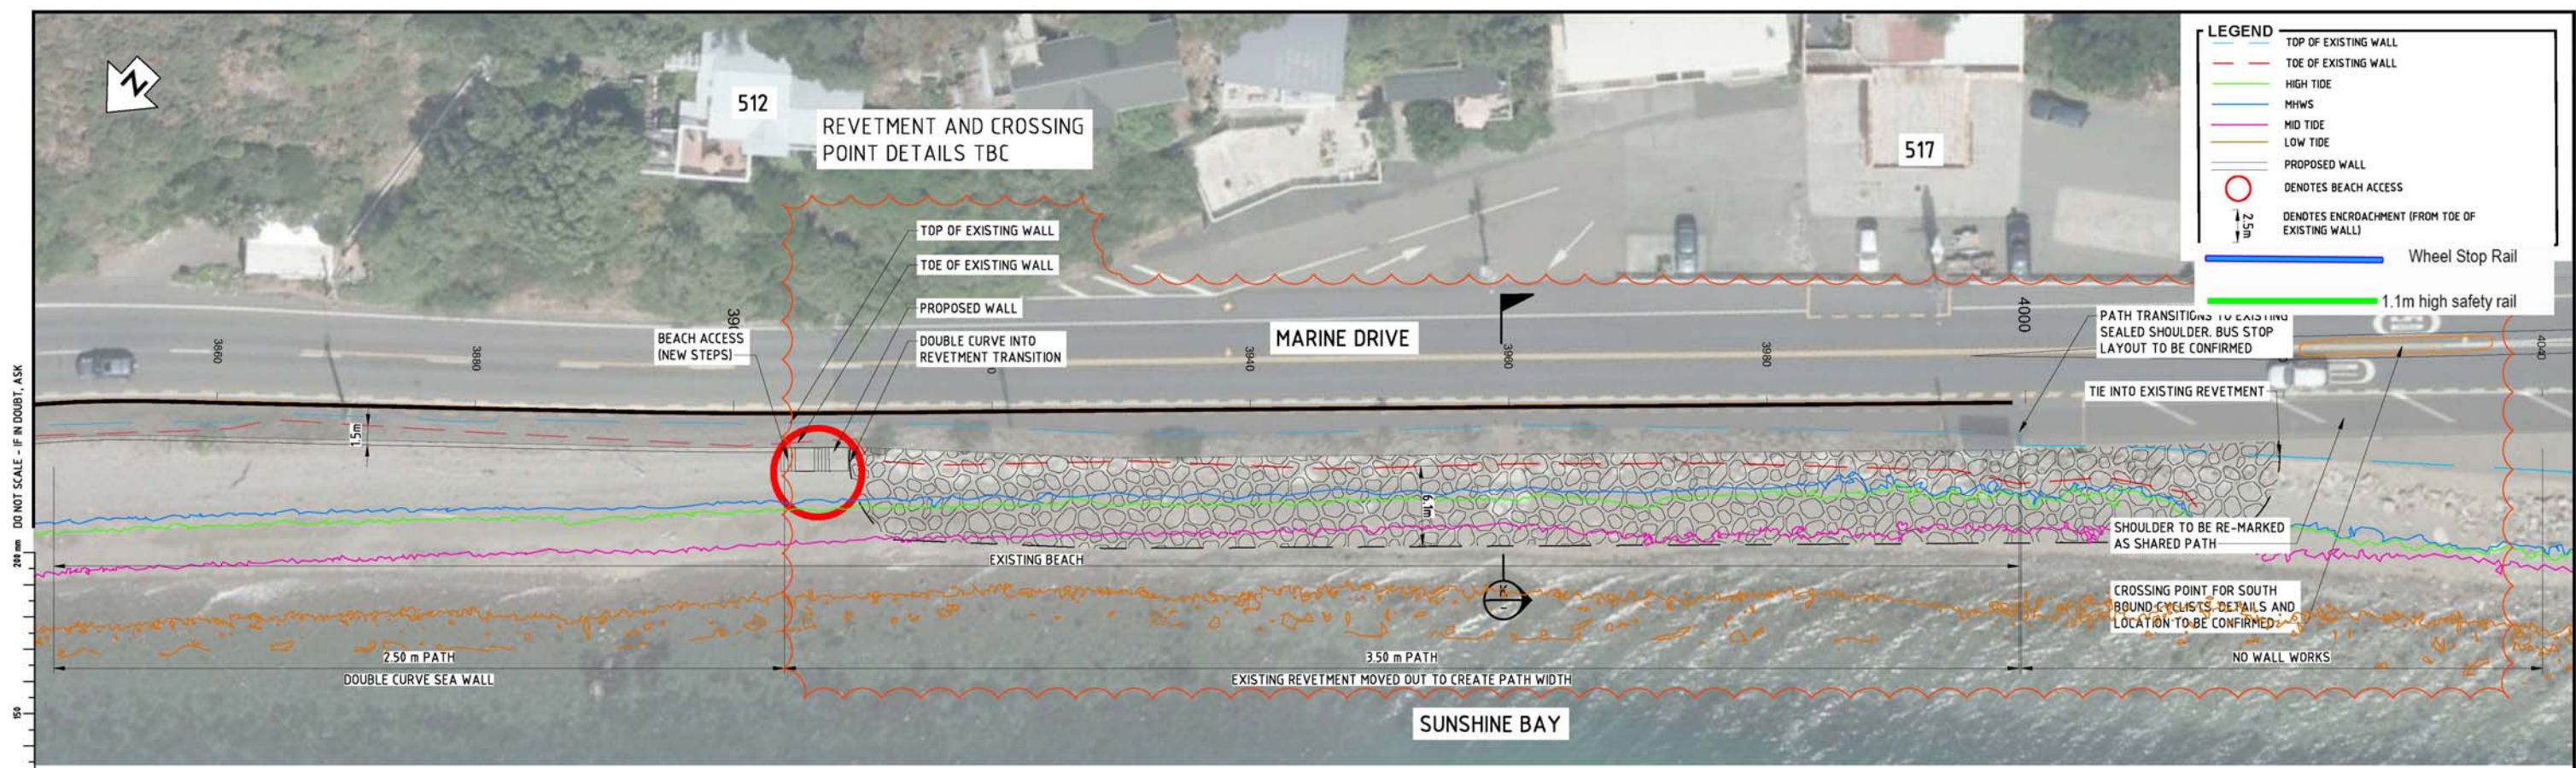

DO NOT SCALE - IF IN DOUBT, ASK

200 mm

95

80

65

50

35


20

5

ORIGINAL SIZE

A1

Last modified: Nov 23 2018 By: Kevin Singh

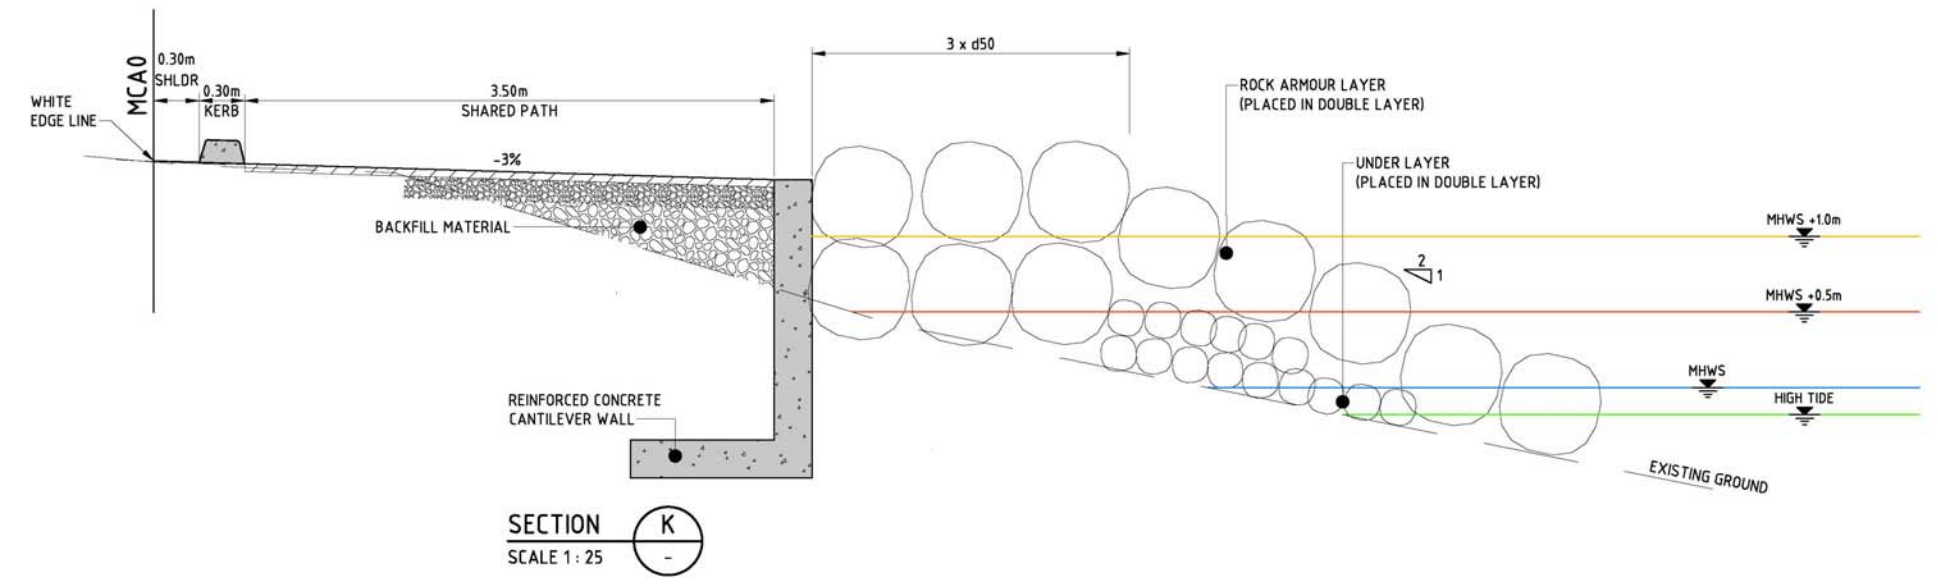

SECTION K
SCALE 1:25

INDICATIVE - SUBJECT TO DETAILED DESIGN NOT FOR CONSTRUCTION


REV	DESCRIPTION	DRN	CHK	APP	DATE	PROF REGISTRATION:
J	FOR CONSENT - ROCK REVETMENT REMOVED AND PATH WIDTH CHANGED	KVS	JP		08/18	
H	FOR CONSENT - MINOR AMENDMENT	KVS	JP		05/18	
G	FOR CONSENT	KVS	JP		04/18	
F	MINOR AMENDMENT	KVS	JP		09.03.2018	
E	MINOR AMENDMENT	KVS	JP		02.03.2018	
D	PRELIMINARY DESIGN	GC	JP		19.09.17	
C	FOR REVIEW - MANY SHEETS ADDED, MANY SHEETS RE-NUMBERED	PJ COOK	JP		08/17	
REV	REVISIONS	DRN	CHK	APP	DATE	



HUTT CITY COUNCIL
EASTERN BAYS SHARED PATH - DBC

PLAN - MCA0
SUNSHINE BAY STATION 3860 - 4040


Status Stamp	WORKING PLOT
Date Stamp	
Scales	1:250 (A1)
Drawing No.	80509137-01-001-C239
Rev.	J

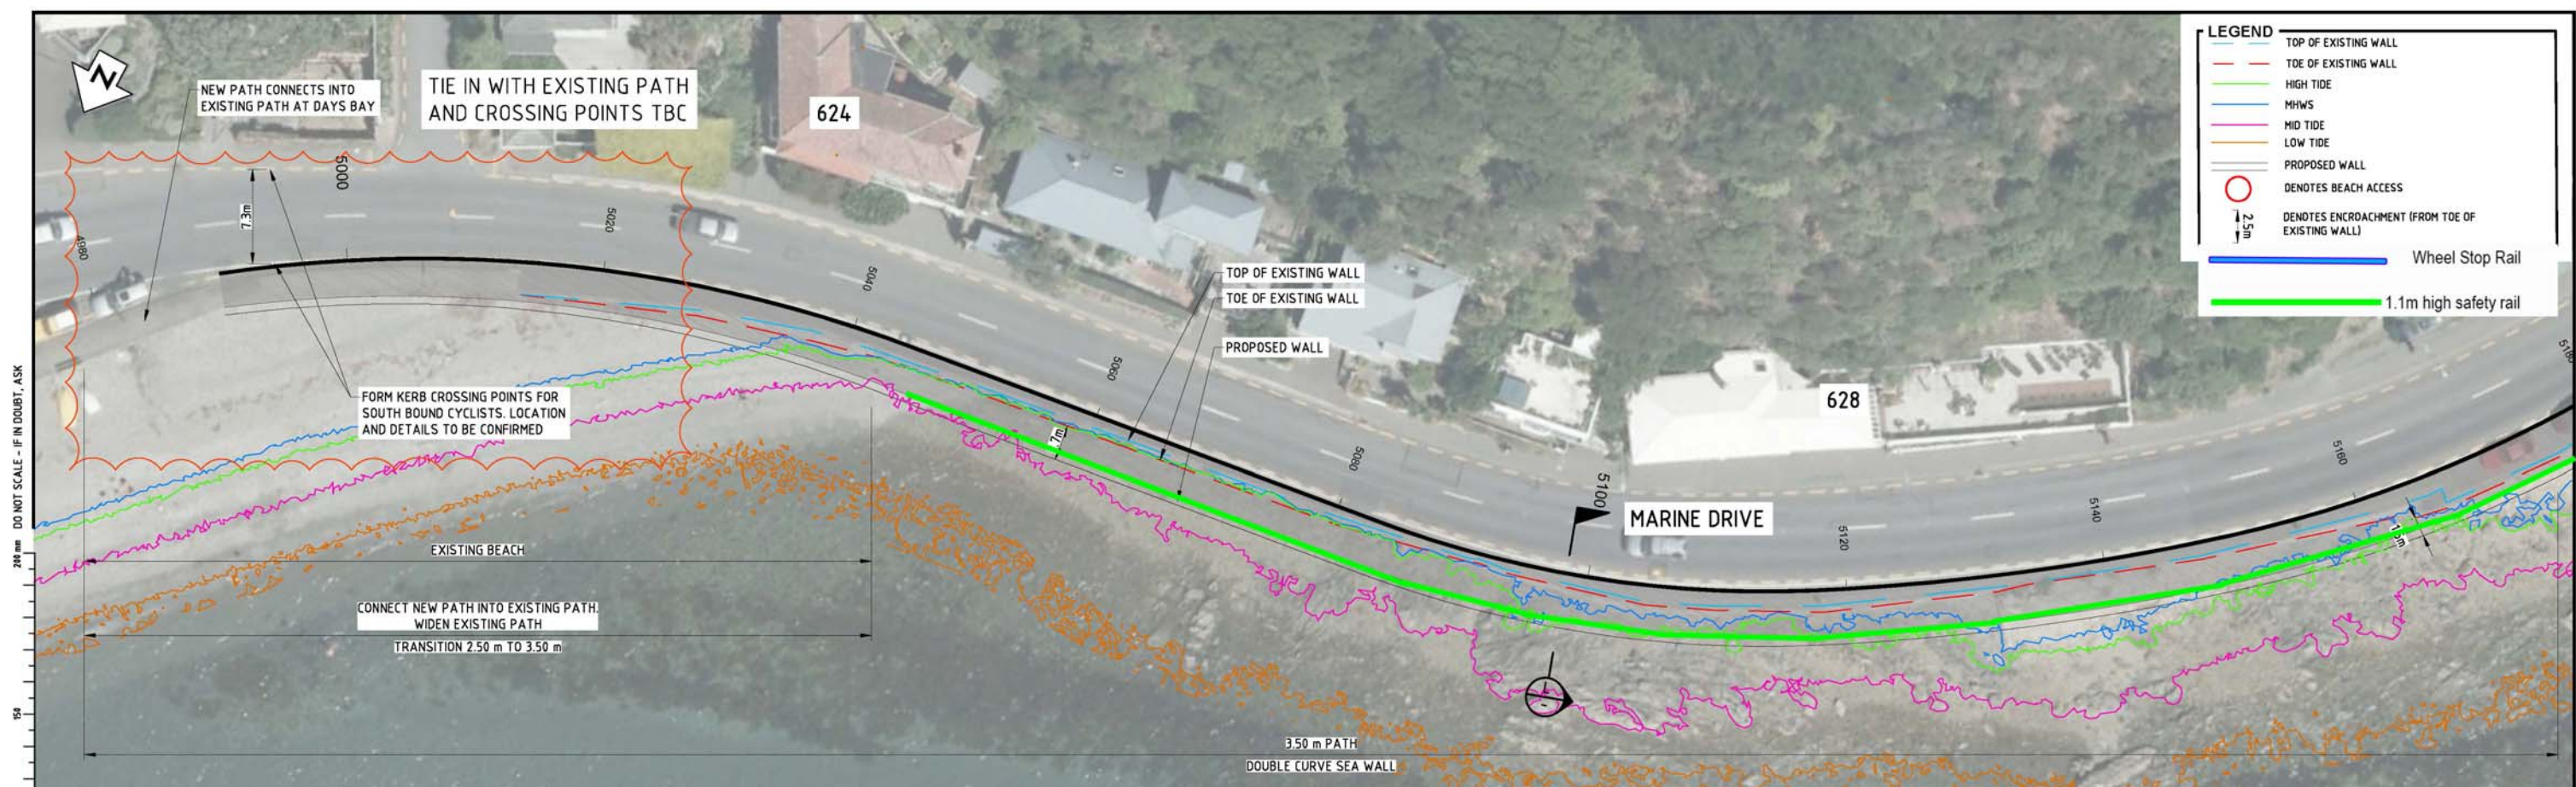

DO NOT SCALE - IF IN DOUBT, ASK

ORIGINAL SIZE A1

Last modified: Nov 23 2018 By Kevin Singh

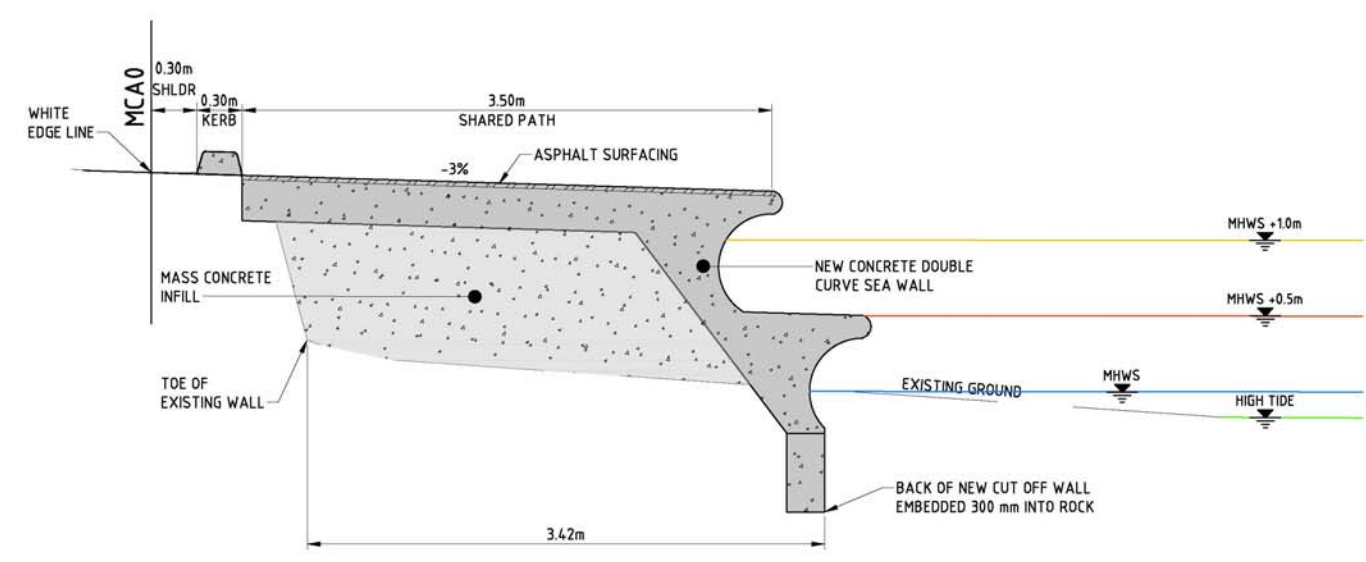

SECTION L
SCALE 1 : 25



INDICATIVE - SUBJECT TO DETAILED DESIGN NOT FOR CONSTRUCTION

REV	DESCRIPTION	DRN	CHK	APP	DATE
J	FOR CONSENT - ROCK REVETMENT REMOVED AND PATH WIDTH CHANGED	KVS	JP		08/18
H	FOR CONSENT - MINOR AMENDMENT	KVS	JP		05/18
G	FOR CONSENT	KVS	JP		04/18
F	MINOR AMENDMENT	KVS	JP		09.03.2018
E	MINOR AMENDMENT	KVS	JP		02.03.2018
D	PRELIMINARY DESIGN	GC	JP		19.03.17
C	FOR REVIEW - MANY SHEETS ADDED, MANY SHEETS RE-NUMBERED	PJ COOK	JP		08/17
	REVISIONS				

SURVEYED	DESIGNED	DRAWN	CAD REVIEW	DESIGN CHECK	DESIGN REVIEW	APPROVED	PROF REGISTRATION:

NOT APPROVED


Client:

HUTT CITY COUNCIL
EASTERN BAYS SHARED PATH - DBC

PLAN - MCA0
WINDY POINT STATION 4980 - 5180

Status Stamp	WORKING PLOT	
Date Stamp		
Scales	AS SHOWN	
Drawing No.	80509137-01-001-C240	Rev. J

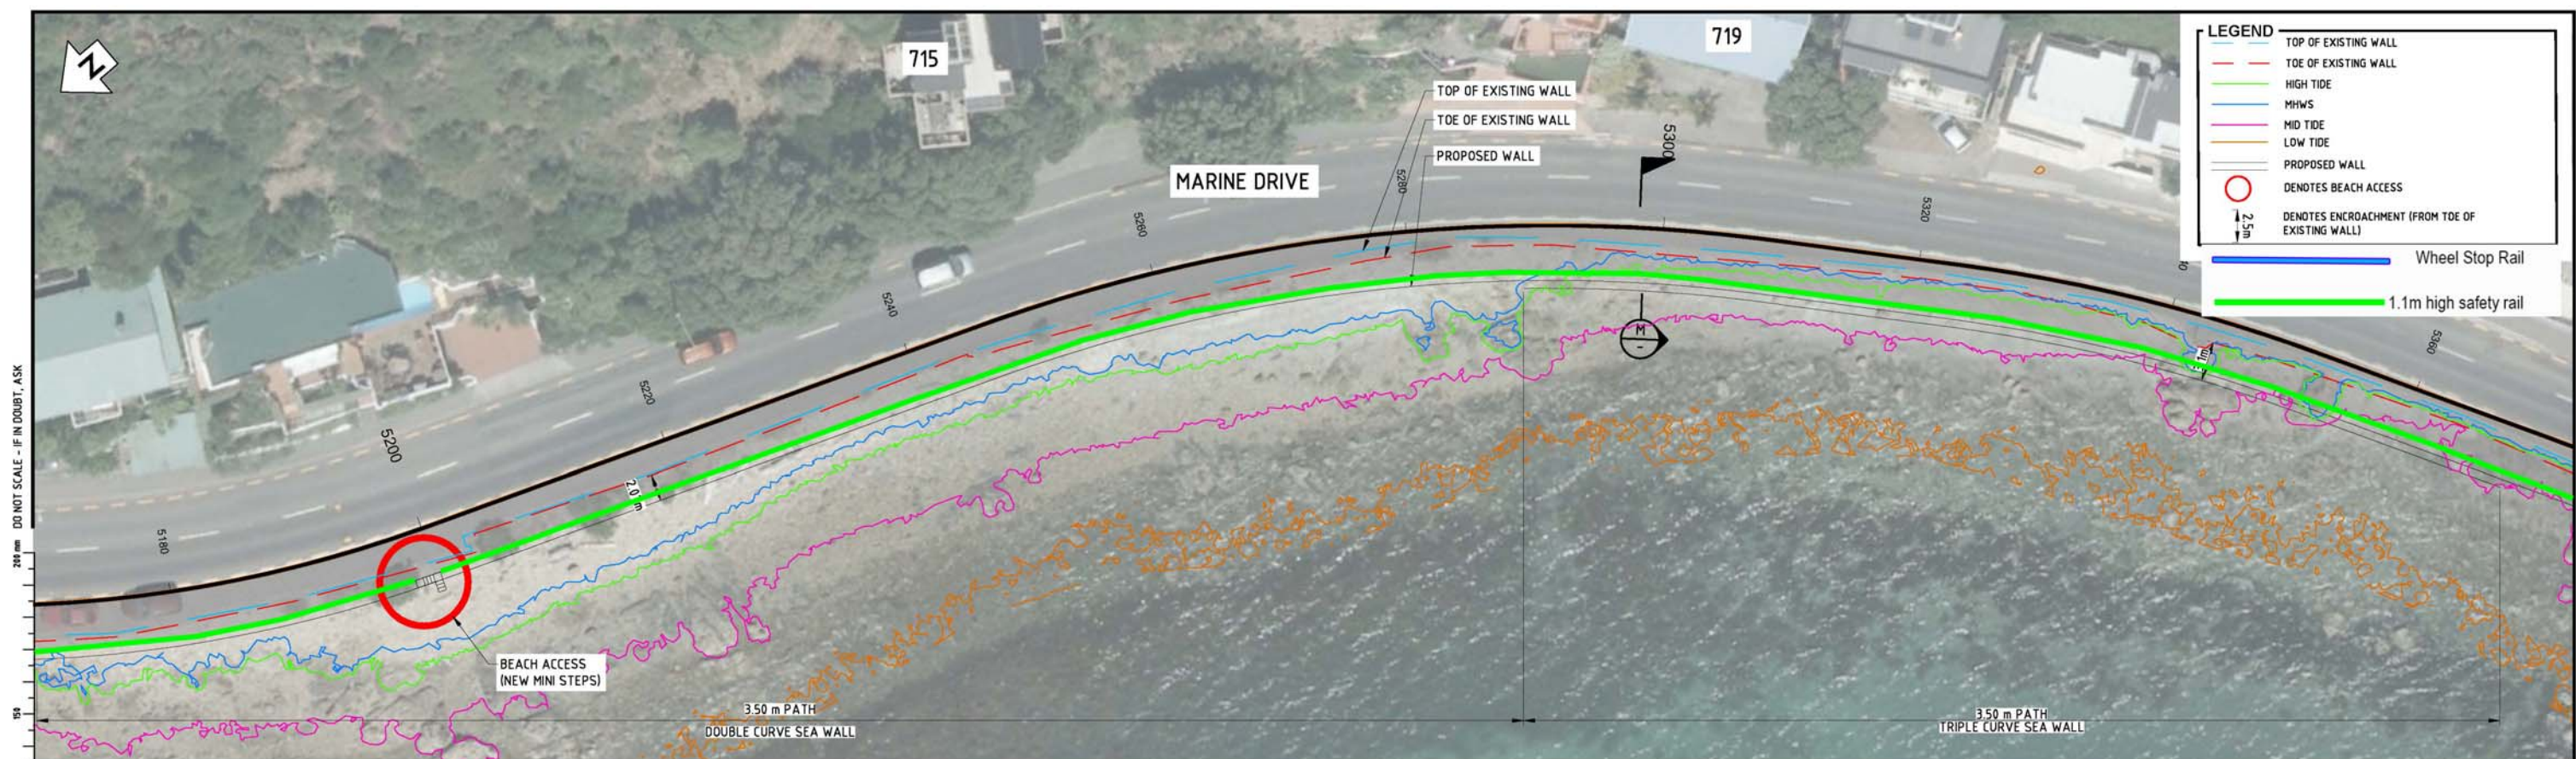


DO NOT SCALE - IF IN DOUBT, ASK

200m

ORIGINAL SIZE A1

Last modified: Nov 23 2018 By Kevin Singh

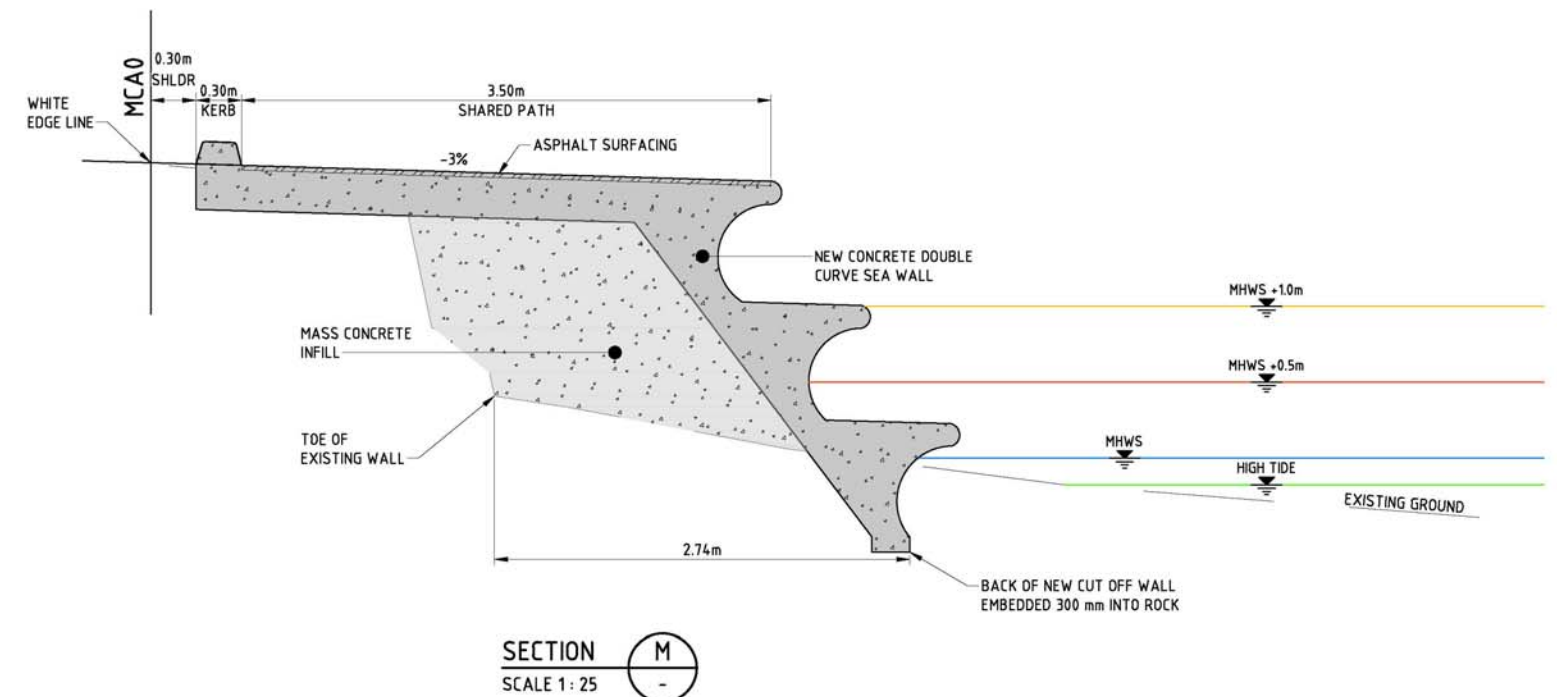

SECTION M
SCALE 1:25

INDICATIVE - SUBJECT TO DETAILED DESIGN NOT FOR CONSTRUCTION

REV	DESCRIPTION	DRN	CHK	APP	DATE
J	FOR CONSENT - ROCK REVETMENT REMOVED AND PATH WIDTH CHANGED	KVS	JP		08/18
H	FOR CONSENT - MINOR AMENDMENT	KVS	JP		05/18
G	FOR CONSENT	KVS	JP		04/18
F	MINOR AMENDMENT	KVS	JP		09.03.2018
E	MINOR AMENDMENT	KVS	JP		02.03.2018
D	PRELIMINARY DESIGN	GC	JP		19.09.17
C	FOR REVIEW - MANY SHEETS ADDED, MANY SHEETS RE-NUMBERED	PJ COOK	JP		08/17
	REVISIONS				

SURVEYED	DESIGNED	DRAWN	CAD REVIEW	DESIGN CHECK	DESIGN REVIEW	APPROVED	PROF REGISTRATION:

NOT APPROVED




HUTT CITY COUNCIL
EASTERN BAYS SHARED PATH - DBC

PLAN - MCAO
WINDY POINT STATION 5180 - 5360

Status Stamp	WORKING PLOT	
Date Stamp		
Scale	AS SHOWN	
Drawing No.	80509137-01-001-C241	Rev. J

LEGEND	
	TOP OF EXISTING WALL
	TOE OF EXISTING WALL
	HIGH TIDE
	MHWS
	MID TIDE
	LOW TIDE
	PROPOSED WALL
	DENOTES BEACH ACCESS
	DENOTES ENCROACHMENT (FROM TOE OF EXISTING WALL)
	Wheel Stop Rail
	1.1m high safety rail

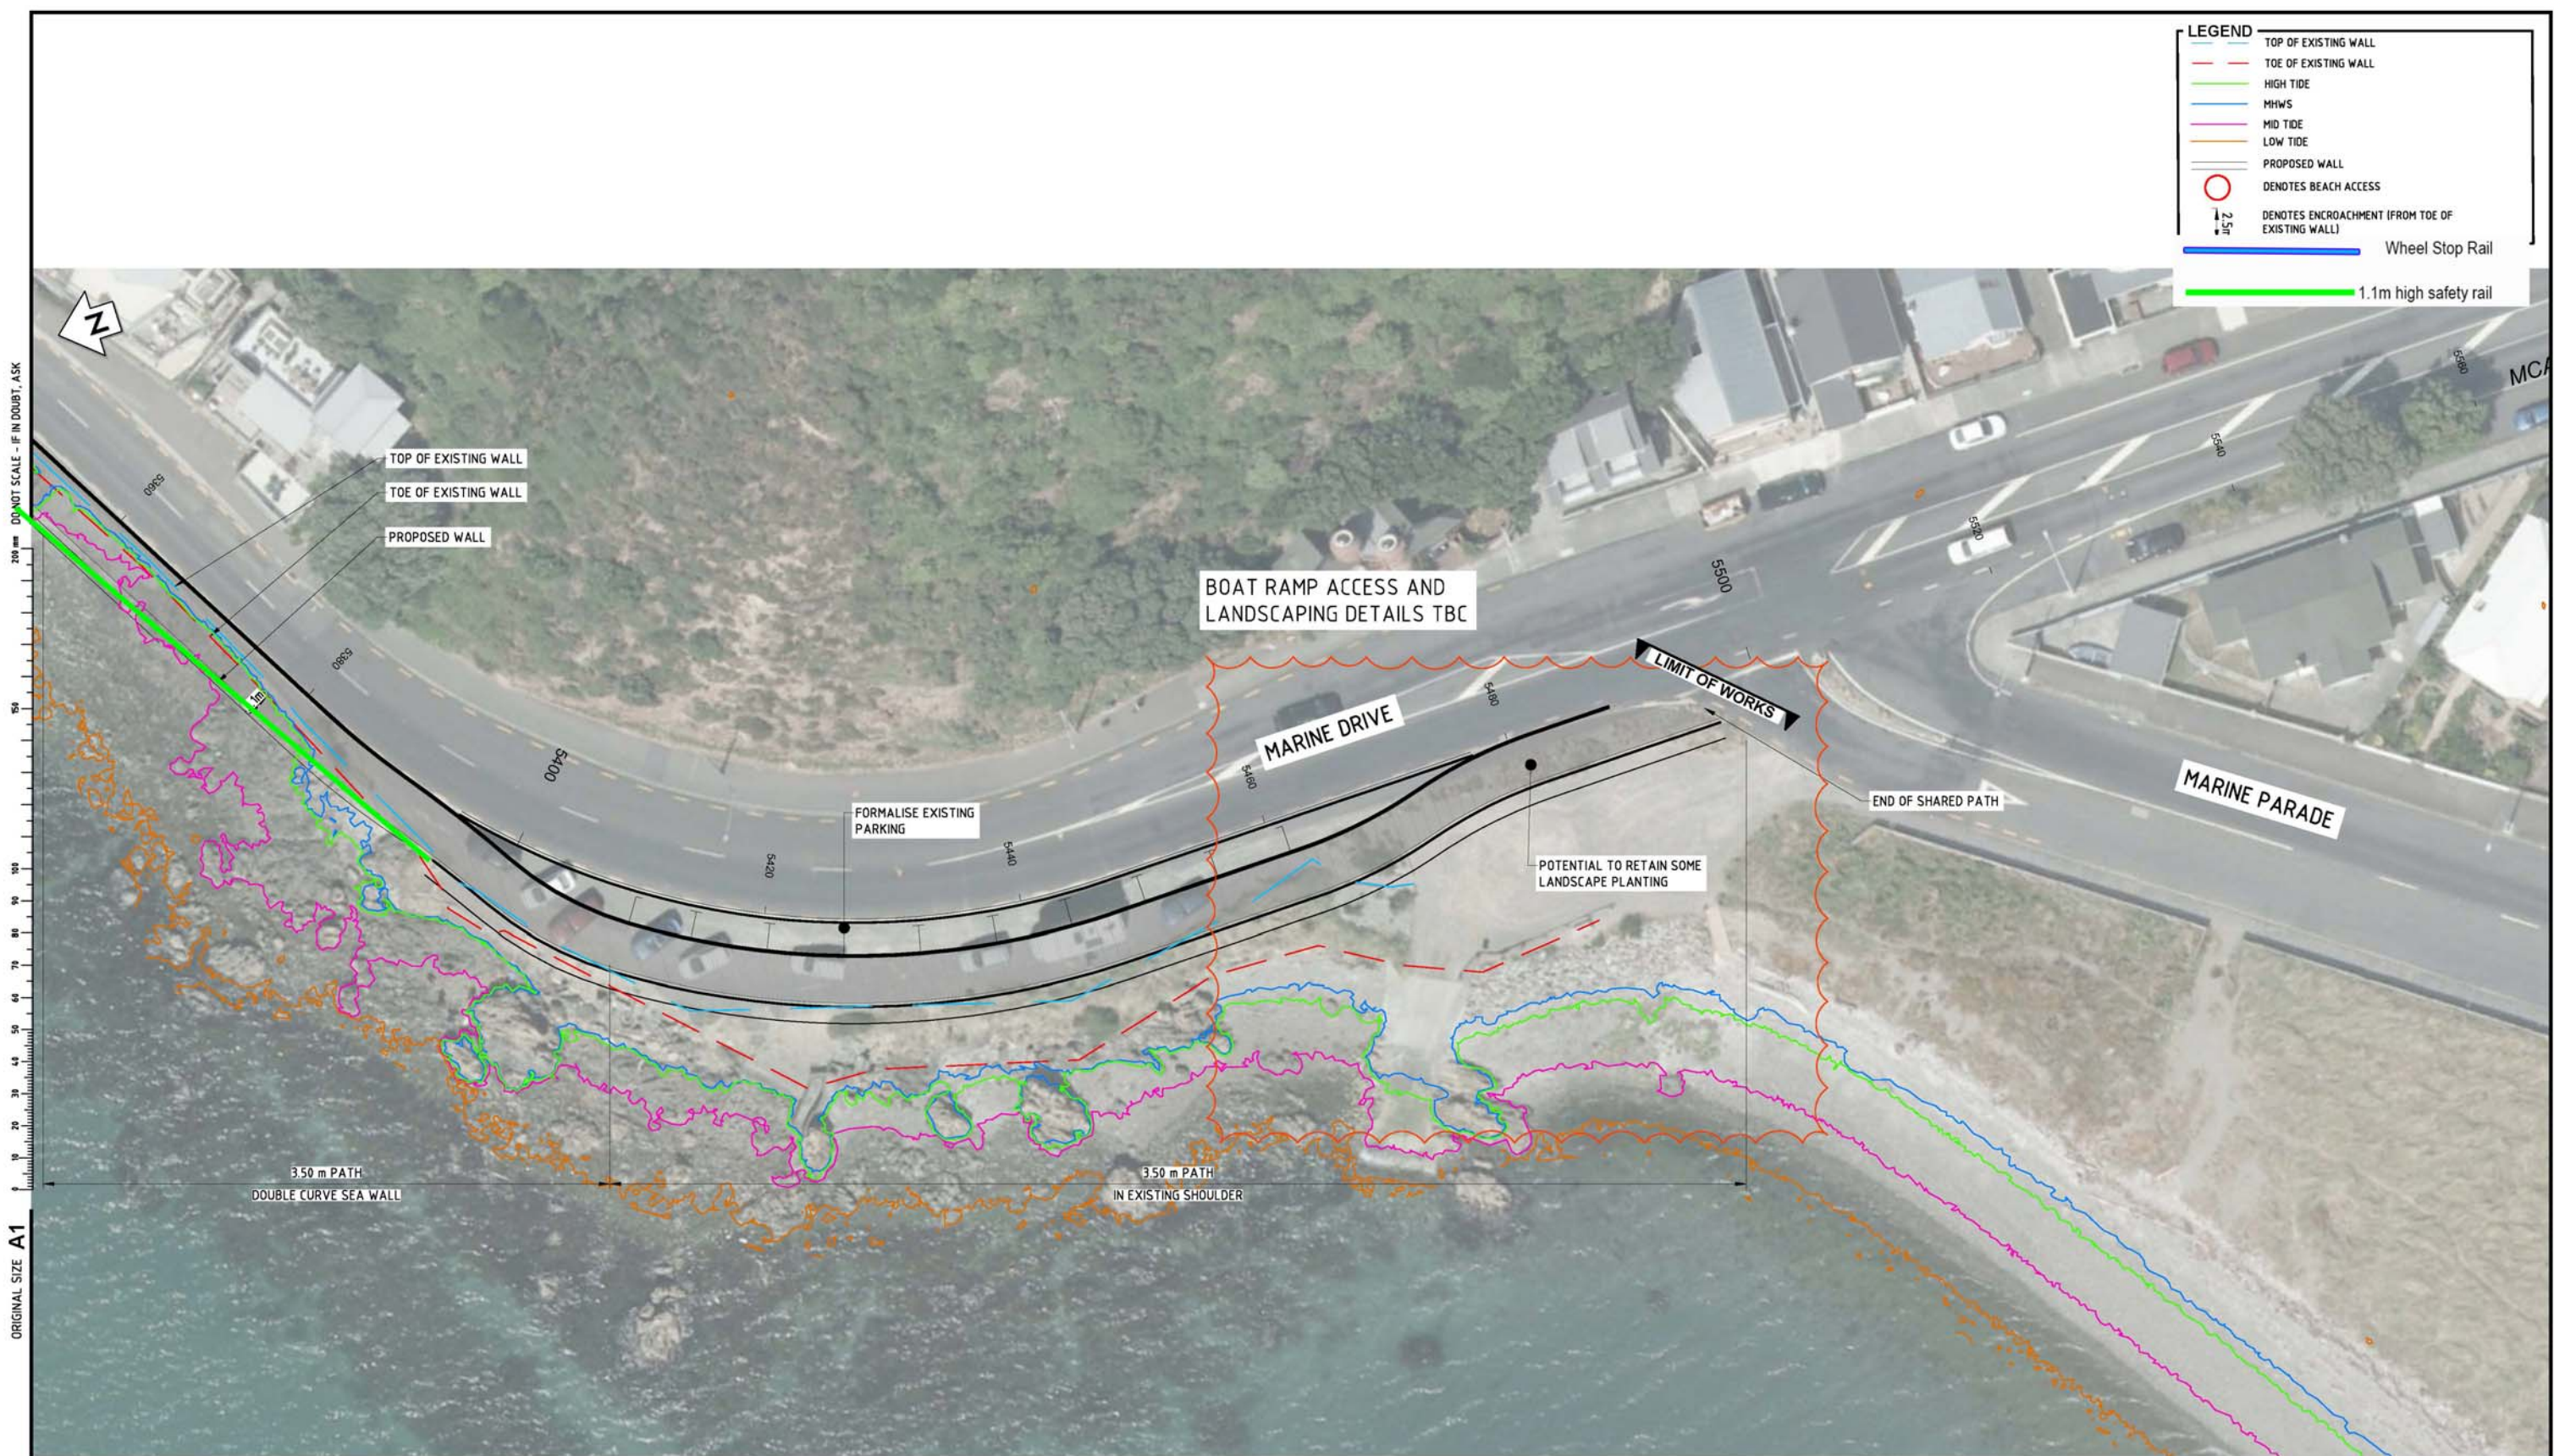

INDICATIVE - SUBJECT TO DETAILED DESIGN NOT FOR CONSTRUCTION

REV	DESCRIPTION	DRN	CHK	APP	DATE
J	FOR CONSENT - ROCK REVETMENT REMOVED AND PATH WIDTH CHANGED	KVS	JP		08/18
H	FOR CONSENT - MINOR AMENDMENT	KVS	JP		05/18
G	FOR CONSENT	KVS	JP		04/18
F	MINOR AMENDMENT	KVS	JP		09 03 2018
E	MINOR AMENDMENT	KVS	JP		02 03 2018
D	PRELIMINARY DESIGN	GC	JP		19 09 17
C	FOR REVIEW - MANY SHEETS ADDED, MANY SHEETS RE-NUMBERED	PJ COOK	JP		08/17
	REVISIONS				

SURVEYED	
DESIGNED	
DRAWN	
CAD REVIEW	
DESIGN CHECK	
DESIGN REVIEW	
APPROVED	NOT APPROVED
PROF REGISTRATION	

Client:

HUTT CITY COUNCIL
EASTERN BAYS SHARED PATH - DBC

PLAN - MCA0
WINDY POINT STATION 5360 - 5500

Status Stamp	WORKING PLOT
Date Stamp	
Scales	AS SHOWN
Drawing No.	80509137-01-001-C242
Rev.	J

Last modified: Aug 24, 2018 By Kevin Singh

DO NOT SCALE - IF IN DOUBT, ASK

ORIGINAL SIZE A1